## SURVEY & REMONUMENTATION

FEB 08 2001



## SECTION

## 2000 REMONUMENTATION PROGRAM LAND CORNER RECORDATION CERTIFICATE Filing Requirement of Act 74, Mich. P.A. 1970

Corner Code #

K-2

RECEIVED FOR DECORD LIBER NO PAGE NO. FILE NO. #121 Vassar

00 DEC 19 PM 1:35

Register of Deeds Stamp & File Number

For corners	in:	VASSAR TWP.
-------------	-----	-------------

Tuscola Located In:

1. Public Land Survey

2. Property Controlling 

in Section S\_\_\_\_\_ T\_\_\_\_ R 3. Miscellaneous


S\_\_\_\_\_ R Property in Sec.

\_ , Recorded Plat 4. Lot No.

5. Private Claims

I, <u>Kari M. Lohela</u>, in a field survey on <u>October 26</u>, 20 <u>00</u> do hereby state that under requirements of P.A. 74, Michigan P.A. of 1970, the corner points mentioned in lines 1 and 2 above were in conformance with regulations and rules therefore as required in the current manual of survey instructions of the United States Department of the Interior, Bureau of Land Management or by a decree of a Court of Law and /or that the corner points mentioned in lines 3, 4 and 5 above were in conformance with the rules of the Michigan Board of Land Surveyors or by a Decree of a Court of Law; established, re-established, monumented, recovered, found as expressed below: expressed below:

NOTE: Not more than 2 corners, all in the same town and range, may be recorded on this certificate.

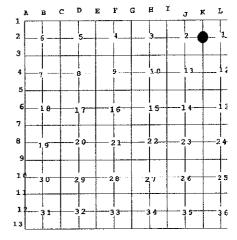

pescription of original monument and accessories and/or subsequent restoration:

1822 G.L.O., JOSEPH FLETCHER, D.S., SET ¼ SEC. POST, BEECH 14 S 16 W 18, BEECH 12 N 73 E 10

MAY 11,1998, SURVEY L.743 PP.123-124, RUSSELL BROWN, PS 24588, FOUND BAR IN MONUMENT BOX, WEST 33.60' SPIKE IN CORNER POST, S30°E 104.60' SPIKE IN P.P., N70°E 38.85' SPIKE IN POST

- Description of corner evidence found and/or method applied in restoring or reestablishing corner: FOUND BOAT SPIKE IN MONUMENT BOX. RECOVERED 3 ACCESSORIES WHICH INDICATE THAT BOAT SPIKE IS IN SAME POSITION AS SURVEY CITED ABOVE.
- Description of monument for corner and accessories established to perpetuate locating the position of the corner:

REMOVED BOAT SPIKE AND PLACED STANDARD BRASS CAP STAMPED K-2, T11N-R8E, OVER 5/8" BAR. ENCASED CAP AND BAR IN CONCRETE IN EXISTING MONUMENT BOX.

N60°E, 38.60' SET REMON. TAG & NAIL IN WEST FACE OF CORNER POST

S35°E, 104.56' SET REMON. TAG & NAIL BELOW FOUND SPIKE IN SW FACE OF UTILITY POLE \$40°W, 64.29' SET REMON. TAG & NAIL IN SE FACE OF 10" PINE

WEST, 33.57' SET REMON. TAG & NAIL ABOVE FOUND SPIKE IN SE FACE OF CORNER POST

Signed by

Feei M. Cle Date 12/18/00

Surveyor's Michigan License No. 44289

APPROVED BY TUSCOLA COUNTY 1600 REMONUMENTATION PEER GROUP MWP

12/13/2000


FEB 08 2001

K-2 T11N-R8E

SECTION



NOTE: 1995 MEASURMENTS BY FIELD ARE TO CORNER L—1, T11N, R8E; MONUMENT WAS CORRECTLY SET AT POSITION L—13, T12N, R8E. MARCH 2000, CONFIRMED BY DUNTON SURVEY FOR TUSCOLA COUNTY ROAD COMMISSION

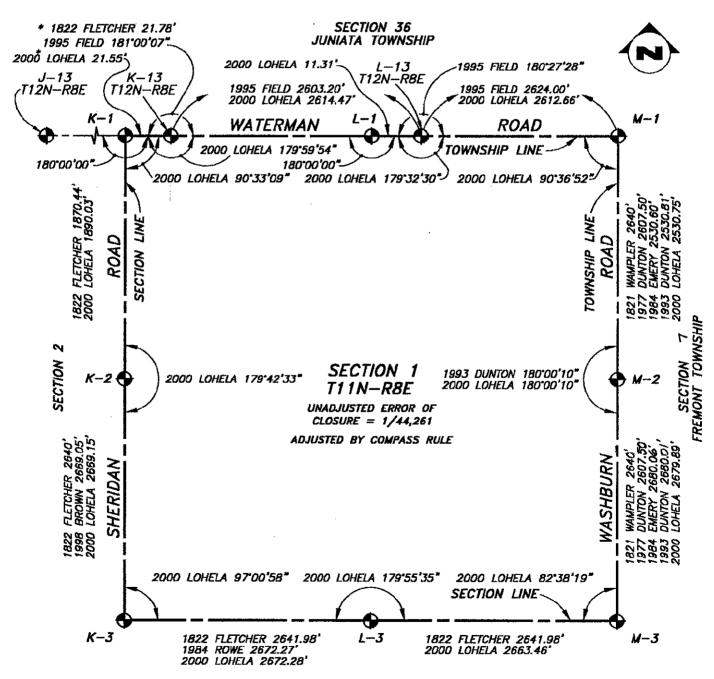

SECTION 12