SURVEY & REMONUMENTATION



FEB 08 2001

SECTION

2000 REMONUMENTATION PROGRAM LAND CORNER RECORDATION CERTIFICATE Filing Requirement of Act 74, Mich. P.A. 1970

RECEIVED	FOR	REC	CORD	
LIBER NO.	8 P.A	GE I ∂S S	10	-

ORDER TO DE 1.25

For corners in: VASSAR TWP.

_	<u>County)</u> Located In	ı; Co	rner Code #
1.	Public Land Survey	T 11N R 8E T R T R T R	<u>K-4</u>
2.	Property Controlling	s T	_ R
	in Section	S T	R
3.	Miscellaneous	S T	R

00 000 13 111 1.3	J
TUSCOLA COURTY FEOR TEC OF PEECS	\neg

Register of Deeds Stamp & File Number

1. Lot No, Record	led P	lat
-------------------	-------	-----


5. Private Claims

Property in Sec.

I, <u>Kari M. Lohela</u>, in a field survey on <u>October 26</u>, 20 <u>00</u> do hereby state that under requirements of P.A. 74, Michigan P.A. of 1970, the corner points mentioned in lines 1 and 2 above were in conformance with regulations and rules therefore as required in the current manual of survey instructions of the United States Department of the Interior, Bureau of Land Management or by a decree of a Court of Law and /or that the corner points mentioned in lines 3, 4 and 5 above were in conformance with the rules of the Michigan Board of Land Surveyors or by a Decree of a Court of Law; established, re-established, monumented, recovered, found as expressed below:

_____ T___

NOTE: Not more than 2 corners, all in the same town and range, may be recorded on this certificate.

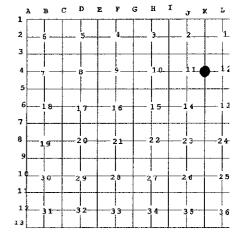

A. Description of original monument and accessories and/or subsequent restoration:

1822 G.L.O., JOSEPH FLETCHER, D.S., SET 1/4 SECTION POST, MAPLE 4 S 27 W 11, MAPLE 4 N 89 W 5

JULY 12, 1977, SURVEY L.477 PP.864-867, KENNETH DUNTON, PS 23503, FOUND BOAT SPIKE IN MON. BOX, N30°E 97.50' RLS TAG 11192 IN P.P., N75°E 27.95' "X" ON TOP OF 42" C.M.P.

SEPT. 29, 1977, LCRC P.47 VASSAR TWP., KENNETH DUNTON, PS 23503, FOUND BOAT SPIKE IN MON. BOX, N30°E 97.50' RLS TAG 11192 IN P.P., N75°E 27.95' "X" ON TOP OF 42" C.M.P., N75°W 30.12'' "X" ON TOP OF 42" C.M.P., S30°W 68.55' RLS TAG 11192 IN 7" ASH

SEPT. 6, 1978, SURVEY L.490 PP.620-622, ARTHUR LEACH, PS 7236, FOUND 1" SQUARE ROD IN MON. BOX, N40°E 97.53' RLS TAG 11192 IN U.P., N85°E 28.00' "X" ON TOP OF 36" C.M.P., N80°W 30.20" "X" ON TOP OF 36" C.M.P.

MARCH 1, 1979, LCRC P.50 VASSAR TWP., ARTHUR LEACH, PS 7236, FOUND SAME OBJECT AND ACCESSORIES AS SURVEY L.490, PP.620-622.

APRIL 22, 1980, SURVEY L.505 P.1440, DAVID ROWE, PS 11192, FOUND SAME OBJECT ACCESSORIES AS LCRC P.47 VASSAR TWP.

AUG. 17, 1984, SURVEY L.546 PP.756-758, DAVID ROWE, PS 11192, FOUND SAME OBJECT AND ACCESSORIES AS SURVEY L.477, PP.864-867

AUG. 10, 1993, SURVEY L.647 PP.1170-1171, JONATHAN FIELD, PS 37276, FOUND SAME OBJECT AND ACCESSORIES AS LCRC P.47 VASSAR TWP.

SEPT. 7, 1993, SURVEY L.647 P.1156-1158, JONATHAN FIELD, PS 37276, FOUND BOAT SPIKE IN MON. BOX, N30°E 100.32' P.K. NAIL IN P.P., N75°E 27.95' "X" ON TOP OF 42" C.M.P., N75°W 30.12'' "X" ON TOP OF 42" C.M.P., S30°W 68.55' RLS TAG 11192 IN 12" ASH, S80°E 34.80' CENTER OF 4" GALV. FENCE CORNER POST

FEB 08 2001

K-4 T11N-R8E

SECTION


B. Description of corner evidence found and/or method applied in restoring or reestablishing corner: FOUND BOAT SPIKE IN MONUMENT BOX. RECOVERED 4 ACCESSORIES WHICH INDICATE THAT BOAT SPIKE IS IN SAME POSITION AS SURVEYS AND LCRC'S CITED ABOVE.

ACCEPTED BOAT SPIKE AS BEST AVAILABLE EVIDENCE OF ORIGINAL CORNER POSITION.

C. Description of monument for corner and accessories established to perpetuate locating the position of the corner:

RAISED BOAT SPIKE WITH ½" BAR AND PLACED STANDARD BRASS CAP STAMPED K-4, T11N-R8E. ENCASED CAP AND BAR IN CONCRETE IN EXISTING MONUMENT BOX.

N30°E, 100.32' SET REMON. TAG & NAIL ABOVE FOUND SPIKE IN WEST FACE OF UTILITY POLE N75°E, 27.98' FOUND CHISELED "X" IN CROWN AT E. END OF 42" C.M.P. CULVERT S30°W, 68.98' SET REMON TAG & NAIL BELOW FOUND PK NAIL IN SE FACE OF 12" ASH

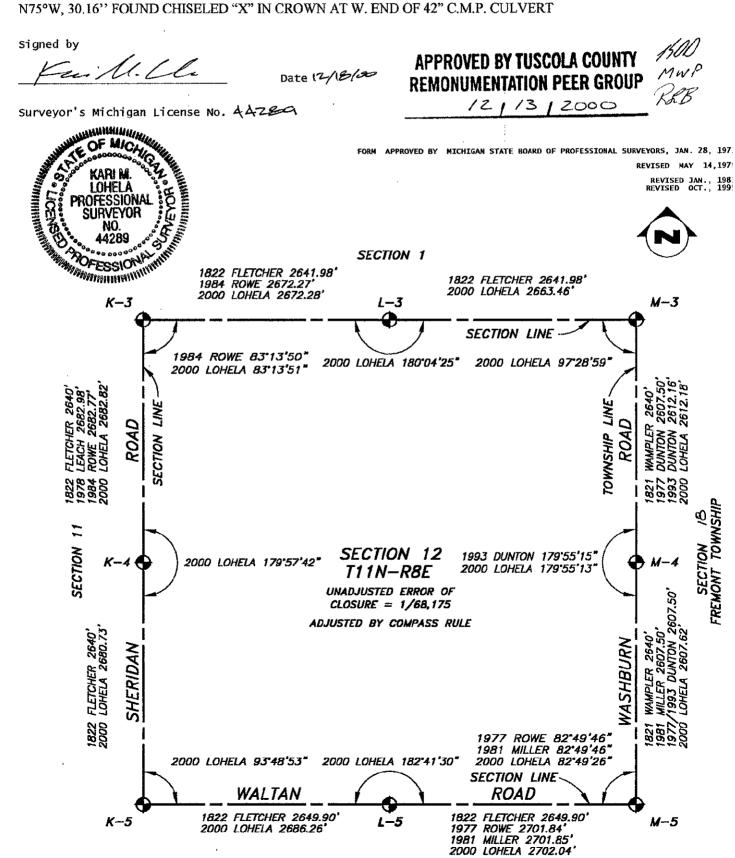

SECTION 13