

COPY

1999 REMONUMENTATION PROGRAM
LAND CORNER RECORDATION CERTIFICATE
Filing Requirement of Act 74, Mich. P.A. 1970

For corners in Vassar Township

<u>Tuscola</u> (County)	Located In:	Corner Code #
1. Public Land Survey	T <u>11</u> N R <u>8</u> E	K-12
	T <u> </u> R <u> </u>	_____
	T <u> </u> R <u> </u>	_____
	T <u> </u> R <u> </u>	_____
2. Property Controlling in Section	S <u> </u> T <u> </u> R <u> </u>	_____
	S <u> </u> T <u> </u> R <u> </u>	_____
3. Miscellaneous Property in Sec.	S <u> </u> T <u> </u> R <u> </u>	_____
	S <u> </u> T <u> </u> R <u> </u>	_____

RECEIVED FOR RECORDS
 LIBER NO. PAGE NO.
 FILE NO. #105
 VASSAR TWP.
 99 DEC 21 PM 3:41
 TUSCOLO COUNTY
 REGISTER OF DEEDS

Register of Deeds Stamp & File Number

4. Lot No. _____, Recorded Plat _____
 5. Private Claims _____

Lionel Roy Emery
 I, P.S. #24593, in a field survey on July 16, 1999 do hereby state that under requirements of P.A. 74, Michigan P.A. of 1970, the corner points mentioned in lines 1 and 2 above were in conformance with regulations and rules therefore as required in the current manual of survey instructions of the United States Department of the Interior, Bureau of Land Management or by a decree of a Court of Law and /or that the corner points mentioned in lines 3, 4 and 5 above were in conformance with the rules of the Michigan Board of Land Surveyors or by a Decree of a Court of Law; established, re-established, monumented, recovered, found as expressed below:

NOTE: Not more than 2 corners, all in the same town and range, may be recorded on this certificate.

	A	B	C	D	E	F	G	H	I	J	K	L	M
1													
2	6		5		4		3		2		1		
3													
4	7		8		9		10		11		12		
5													
6	18		17		16		15		14		13		
7													
8	19		20		21		22		23		24		
9													
10	30		29		28		27		26		25		
11													
12	31		32		33		34		35		36		
13													

A. Description of original monument and accessories and/or subsequent restoration:

June, 1822 G.L.O. Notes, Joseph Fletcher, D.S. Set 1/4 section post, Hemlock 20" N57°W 23 links, Hemlock 10" S49°W 21 links. April 24, 1971 L.C.R.C. Page 8 by David T. Rowe, P.S. #11192, found nail & washer, replaced with "T" iron, S85°E 34.88' nail & cap in T. pole, S15°E 155.23' nail & cap in T. Pole, N20°W 107.35' nail & cap in 8" Poplar. March 8, 1973 Survey L-430, P-627 & 628 by David T. Rowe, P.S. #11192, same object and accessories as L.C.R.C. Page 8. June 7, 1978 Survey L-491, P-999 & 1000 by David T. Rowe, P.S. #11192, same object and accessories as L-430, P-627 & 628 with the addition of one accessory at S45°E 173.88' NW corner of trailer house.

Sec. A con't on back of form.

B. Description of corner evidence found and/or method applied in restoring or reestablishing corner:

Found "T" iron in monument box and accepted same as the best evidence of the original corner position.


C. Description of monument for corner and accessories established to perpetuate locating the position of the corner:

Removed "T" iron & perpetuated with 5/8" iron rod & standard brass cap stamped K-12, T11N-R8E. Encased rod & cap in concrete in monument box.
 N35°E 26.83' set 1/2" iron rod in road shoulder.
 S80°E 19.61' set "V" notch atop E. end 36" CMP.
 S85°W 21.22' set "V" notch atop W. end 36" CMP.
 S50°W 41.85' set remon. tag in utility pole stub, top center, fnd. #11192 tag & P.K. also.

Due to the untimely illness of Mr. Emery, I, Kenneth D. Dunton, P.S. #23503, have reviewed Mr. Emery's field notes and have prepared this form.

Signed by [Signature] Date 12-3-99
 Surveyor's Michigan License No. 23503

APPROVED
12-13-99 KUL
 RLB
 JMG

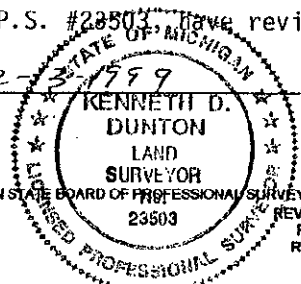

COPY

Section A Con't.

June 8, 1984 Survey L-543, P-1359 & 1360 by David T. Rowe, P.S. #11192, fnd. "T" iron, S85°E 35.25' nail & cap in T. Pole, S45°W 42.28' L.S. #11192 tag in T. Pole, N20°W 107.35' nail & cap in 8" Poplar. Dec. 21, 1985 Survey L-590, P-1143 & 1144 by Stephan J. Szyszkowski, P.S. #33986, found "T" iron, S15°E 173.82' fnd. nail & cap in P. Pole, S45°E 155.25' NW corner trailer house, East 32.95' found rerod w/cap #11192, S85°E 35.35' found nail & cap in W. face wood post, S45°W 41.79' set P.K. nail & tag #11192 in top c/l sawed off T. Pole, N20°W 107.35' nail & cap in S. face 8" Poplar (now overgrown). Nov. 29, 1989 Survey L-598, P-1434 through 1437 by Stephan J. Szyszkowski, P.S. #33986, same object and accessories as L-590, P-1143 & 1144 except deleted nail in 8" Poplar NW. Nov. 15, 1996 Survey L-706, P-777 & 778 by John M. Juras, P.S. #33980, T-iron, accessories same as L.C.R.C. Page 8.

