## SURVEY & REMOVIMENTATION FEB 0 8 2001



## **SECTION**

For corners in: VASSAR TWP.

## 2000 REMONUMENTATION PROGRAM LAND CORNER RECORDATION CERTIFICATE Filing Requirement of Act 74, Mich. P.A. 1970

RECEIVED FOR RECORD
LIBER NO PAGE NO.
FILE HO # 123 Vassar
00 DEC 19 PH 1:35
gray mehren
TUSCOLA COUNTY REGISTER OF DEEDS

> Register of Deeds Stamp & File Number

T R

2. Property Controlling S T R

in Section S T R

3. Miscellaneous S T R


Property in Sec. S T R

4. Lot No. \_\_\_\_\_\_\_, Recorded Plat

5. Private Claims

I, <u>Kari M. Lohela</u>, in a field survey on <u>october 26</u>, 20 <u>00</u> do hereby state that under requirements of P.A. 74, Michigan P.A. of 1970, the corner points mentioned in lines 1 and 2 above were in conformance with regulations and rules therefore as required in the current manual of survey instructions of the United States Department of the Interior, Bureau of Land Management or by a decree of a Court of Law and /or that the corner points mentioned in lines 3, 4 and 5 above were in conformance with the rules of the Michigan Board of Land Surveyors or by a Decree of a Court of Law; established, re-established, monumented, recovered, found as expressed below:

NOTE: Not more than 2 corners, all in the same town and range, may be recorded on this certificate.

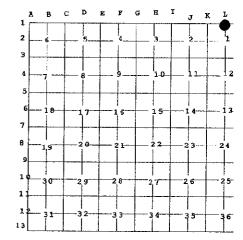

A. Description of original monument and accessories and/or subsequent restoration:

G.L.O. NOT SET

B. Description of corner evidence found and/or method applied in restoring or reestablishing corner:

FOUND 1/2" REBAR 0.06' NORTH OF STD. TOWNSHIP LINE.

EXTENDED NORTH-SOUTH  $\frac{1}{4}$  LINE SOUTHERLY, FROM  $\frac{1}{2}$ " REBAR AND CORNER L-3, TO INTERSECTION WITH STD. TOWNSHIP LINE. SET AMENDED CORNER ON STD. TOWNSHIP LINE.

C. Description of monument for corner and accessories established to perpetuate locating the position of the corner:

REMOVED 1/2" REBAR AND SET 36" CONCRETE MONUMENT WITH STANDARD BRASS CAP STAMPED L-1 AC (AMENDED CORNER), T11N-R8E.

N40°E, 32.24' SET REMON. TAG & NAILABOVE FOUND NAIL & TAG IN SE FACE OF 10" ELM CLUMP EAST, 11.31' FOUND TUSCOLA COUNTY MONUMENT STAMPED L-13, T12N, R8E

S50°E, 74.30' FOUND REMON. TAG & NAIL IN W. FACE OF UTILITY POLE

S35°W, 62.22' SET REMON. TAG & NAIL IN SE FACE OF 6" CEDAR

N70°W, 43.44' SET REMON. TAG & NAIL IN SOUTH FACE OF 12" POPLAR

Signed by

Fail. Ch

Date 12/18/00

APPROVED BY TUSCOLA COUNTY REMONUMENTATION PEER GROUP

12/13/2000

ISOU MWP RXB

Surveyor's Michigan License No. 44-7899

FORM APPROVED BY MICHIGAN STATE BOARD OF PROFESSIONAL SURVEYORS, JAN. 28, 1971


REVISED MAY 14,1975

REVISED JAN., 1983 REVISED OCT., 1995 FEB 08 2001

SECTION



NOTE: 1995 MEASURMENTS BY FIELD ARE TO CORNER L-1, T11N, R8E; MONUMENT WAS CORRECTLY SET AT POSITION L-13, T12N, R8E. MARCH 2000, CONFIRMED BY DUNTON SURVEY FOR TUSCOLA COUNTY ROAD COMMISSION

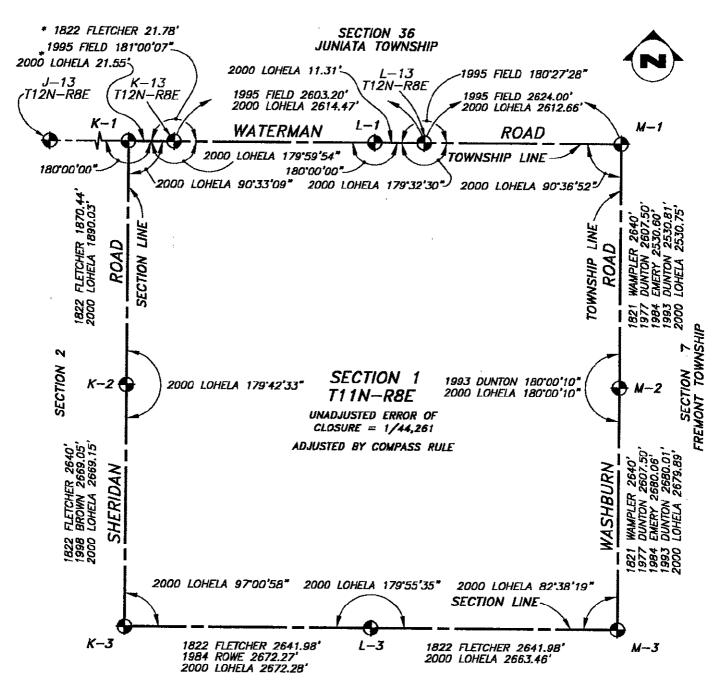

SECTION 12