

1999 REMONUMENTATION PROGRAM
 LAND CORNER RECORDATION CERTIFICATE
 Filing Requirement of Act 74, Mich. P.A. 1970

COPY

For corners in Vassar Township

<u>Tuscola</u> (County)	Located In:	Corner Code #
1. Public Land Survey	T11N R 8E	L-7
	T R	
	T R	
	T R	
2. Property Controlling in Section	S T R	
	S T R	
3. Miscellaneous Property in Sec.	S T R	
	S T R	

RECEIVED FOR RECORDS
 LIBER NO. _____ PAGE NO. _____
 FILE NO. 113
Vassar Twp.
 99 DEC 21 PM 3:41
 TUSCOLA COUNTY
 REGISTER OF DEEDS
 Register of Deeds Stamp & File Number

4. Lot No. _____, Recorded Plat _____
 5. Private Claims _____

Lionel Roy Emery
 I, P.S. #24593, in a field survey on July 21, 1999 do hereby state that under requirements of P.A. 74, Michigan P.A. of 1970, the corner points mentioned in lines 1 and 2 above were in conformance with regulations and rules therefore as required in the current manual of survey instructions of the United States Department of the Interior, Bureau of Land Management or by a decree of a Court of Law and/or that the corner points mentioned in lines 3, 4 and 5 above were in conformance with the rules of the Michigan Board of Land Surveyors or by a Decree of a Court of Law, established, re-established, monumented, recovered, found as expressed below:

A	B	C	D	E	F	G	H	I	J	K	L	M
1												
2	6		5		4		3		2		1	
3												
4	7		8		9		10		11		12	
5												
6	18		17		16		15		14		13	
7												
8	19		20		21		22		23		24	
9												
10	30		29		28		27		26		25	
11												
12	31		32		33		34		35		36	
13												

NOTE: Not more than 2 corners, all in the same town and range, may be recorded on this certificate.

A. Description of original monument and accessories and/or subsequent restoration:

June, 1822 G.L.O. Notes, Joseph Fletcher, D.S. Set 1/4 section post, W. Cedar 12" N24°E 5 links, Hemlock 9" N80°W 12 links. Jan. 5, 1898 Survey of Sec. 13 by G. B. Felton, County Surveyor, set from measure, C. P. & broken kettle at corner. No accessories given. April 8, 1898 Survey of Sec. 24 by G. B. Felton, County Surveyor, previously set, C.P. & broken kettle at corner. No accessories given. May 2, 1995 Survey L-681, P-1407 & 1408 by Earl E. Gravlin, P.S. #23510, found axle shaft 1.5'± E. of corner post, North 28.5' 18" Elm, South 57.20' state tag in P. Pole, S70°W 140.5' P. Pole.

B. Description of corner evidence found and/or method applied in restoring or reestablishing corner:

Found 1/2" iron rod & checked two accessories from 1995 Gravlin survey. Accepted 1/2" iron rod as the best evidence of the original corner position.

C. Description of monument for corner and accessories established to perpetuate locating the position of the corner:


Removed 1/2" iron rod & perpetuated with 36" concrete monument with standard brass cap stamped L-7, T11N-R8E. Set carsonite post 0.5' North.
 S05°W 57.11' set remon. tag & nail above M.S.H.D. tag fnd. in W. face P. Pole.
 S20°W 12.48' set remon. tag & nail in E. face 14" Poplar.
 S70°W 71.10' set remon. tag & nail in NW face 14" Poplar.
 N05°W 28.47' set remon. tag & nail in E. face 18" Elm.

Due to the untimely illness of Mr. Emery, I, Kenneth D. Dunton, P.S. #23503, have reviewed Mr. Emery's field notes and have prepared this form.

Signed by [Signature]
 Surveyor's Michigan License No. 23503

Date 12-13-99

APPROVED
12-13-99
 KUL
 RUB
 JMG

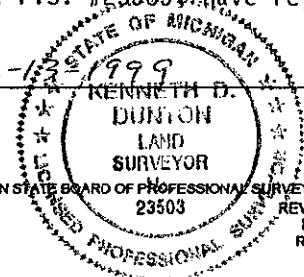

COPY

