

SURVEY & REMONUMENTATION

DEC 02 1993

COMMISSION

**1993 REMONUMENTATION PROGRAM
LAND CORNER RECORDATION CERTIFICATE**

Filing Requirement of Act 74, Mich. P.A. 1970

For corners in

VASSAR TOWNSHIP

TUSCOLA
(County)

Located In:

Corner Code ##

- | | | | |
|------------------------------------|---------------|--------------|------------|
| 1. Public Land Survey | T <u>11</u> N | R <u>8</u> E | <u>M-2</u> |
| | T _____ | R _____ | _____ |
| | T _____ | R _____ | _____ |
| | T _____ | R _____ | _____ |
| 2. Property Controlling in Section | S _____ | T _____ | R _____ |
| | S _____ | T _____ | R _____ |
| 3. Miscellaneous Property in Sec. | S _____ | T _____ | R _____ |
| | S _____ | T _____ | R _____ |

4. Lot No. _____, Recorded Plat _____
5. Private Claims _____

RECEIVED FOR RECORD
 VASSAR & TUSCOLA
 LIBER NO. _____ PAGE NO. _____
 FILING NO. 489
 93 OCT 22 PM 2:43
 VIRGINIA H. HALLAHAN
 TUSCOLA COUNTY
 REGISTER OF DEEDS

Register of Deeds Stamp & File Number

I, Kenneth D. Dunton, in a field survey on August 7, 19 93, do hereby certify that under requirements of P.A. 74, Michigan P.A. of 1970, the corner points mentioned in lines 1 and 2 above were in conformance with regulations and rules therefore as required in the current manual of survey instructions of the United States Department of the Interior, Bureau of Land Management or by a decree of a Court of Law and/or that the corner points mentioned in lines 3, 4 and 5 above were in conformance with the rules of the Michigan Board of Land Surveyors or by a Decree of a Court of Law; established, re-established, monumented, re-monumented, recovered, found as expressed below:

	A	B	C	D	E	F	G	H	I	J	K	L	M
2	6		5		4		3		2		1		0
3													
4	7		8		9		10		11		12		
5													
6	18		17		16		15		14		13		
7													
8	19		20		21		22		23		24		
9													
10	30		29		28		27		26		25		
11													
12	31		32		33		34		35		36		
13													

NOTE: Not more than 4 corners, all in the same town and range, may be recorded on this certificate.

A. Description of original monument and accessories and/or subsequent restoration:

1821 G.L.O. Notes
Joseph Wampler, D.S.
Set 1/2 mi. post
Pine 36" S16°E 11.88'
Beech 11" N26°W 12.54'

July 8, 1977 Act 74 Vassar Township, Page 41 by Kenneth D. Dunton, R.L.S. #23503 with Rowe Engineering, Caro, MI
Found nothing from large excavation on fence line west. Set on straight line & proportional distance between NE corner Section 1, T11N-R8E & NE corner Section 13, T11N-R8E, set 1/2" re-rod and cap #11192.
North 79'± to old fence line West.
N50°W 45.73' R.L.S. 11192 tag in 6" double pine.
S80°W 46.32' R.L.S. 11192 tag in 12" pine.
S40°W 70.17' R.L.S. 11192 tag in 7" pine.

Note: Section A. continued on back of form.

B. Description of corner evidence found and/or method applied in restoring or reestablishing corner:

Found 1/2" re-rod and accessories as established by me in 1977 per Act 74, Page 41, Vassar Township. Also, found 1/2" re-rod and accessories as established by Emery in 1983 per Act 74, Page 67, Vassar Township & Surveys Liber 538, Pages 487, 488, 949 & 950.

Due to the lack of information between 1821 and the present date and the extent of the field work performed by Emery in the East 1/2 of Section 1 to satisfy the acreage as set out by Fletcher, D.S. per the township plat for Section 1, T11N-R8E, I accept the corner location established by Emery in 1983 as being the proper corner M-2.

C. Description of monument for corner and accessories established to perpetuate locating the position of the corner:


Set 4" x 36" concrete monument with 36" x 5/8" rod through center and 2" standard brass cap stamped corner M-2, T11N-R8E. Placed monument box over monument.
S33°49'W 55.70' set T.C. Re-mon. tag & spike in SE face of Southerly tree of twin 12" pines.
N88°03'W 35.12' set T.C. Re-mon. tag & spike in N. face p. pole.
N84°01'56"W 33.21' fnd. 1/2" re-rod & cap # 24593.
N46°43'W 47.34' set T.C. Re-mon. tag & spike in NE face new p. pole.
S78°49'E 43.24' set T.C. Re-mon. tag & spike in N. face 8" elm.
S01°57'26"E 76.99' fnd. 1/2" rod previously filed by me as corner M-2.

Signed by



Date September 27, 1993

Surveyor's Michigan License No. 23503

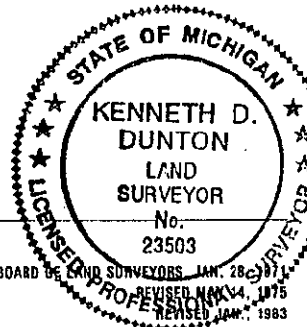

APPROVED

10-4-92

1500
7/21/93

Continued from Section A. on front of this form:

December 22, 1983 Act 74, Vassar Township 11-8 Page 67 by Lionel R. Emery, R.L.S. #24593.
Post set in 1821 by Wampler, D.S.; subsequent restoration by John Martin, R.L.S. and Kenneth Dunton, R.L.S. NOTE: Martin's restoration was corner M-2 of T11N-R7E.

Did not find Martin's accessories. Found accessories placed and recorded by Dunton. Accessorie found not accepted--placed 1/2" re-rod in range line at Wampler's record distance of 58.6 chains north of Evergreen Creek crossing range line. This position aligns with old fence to West.

N45°E, 50.87' nail in 4 x 4 post.


S01°58'E 77.14' 1/2" re-rod.

S30°W 55.76' R.L.S. 11192 tag in pine.

N86°25'53"W 33.09' 1/2" dia. re-rod w/24593.

January 16, 1984 Survey Liber 538, Pages 487 & 488 by Lionel R. Emery, R.L.S. #24593.
Information same as filed on Act 74 form, Vassar Township, Page 67. See above.

January 24, 1984 Survey Liber 538, Pages 949 & 950 by Lionel R. Emery, R.L.S. #24593.
Information same as filed on Act 74 form, Vassar Township, Page 67. See above.

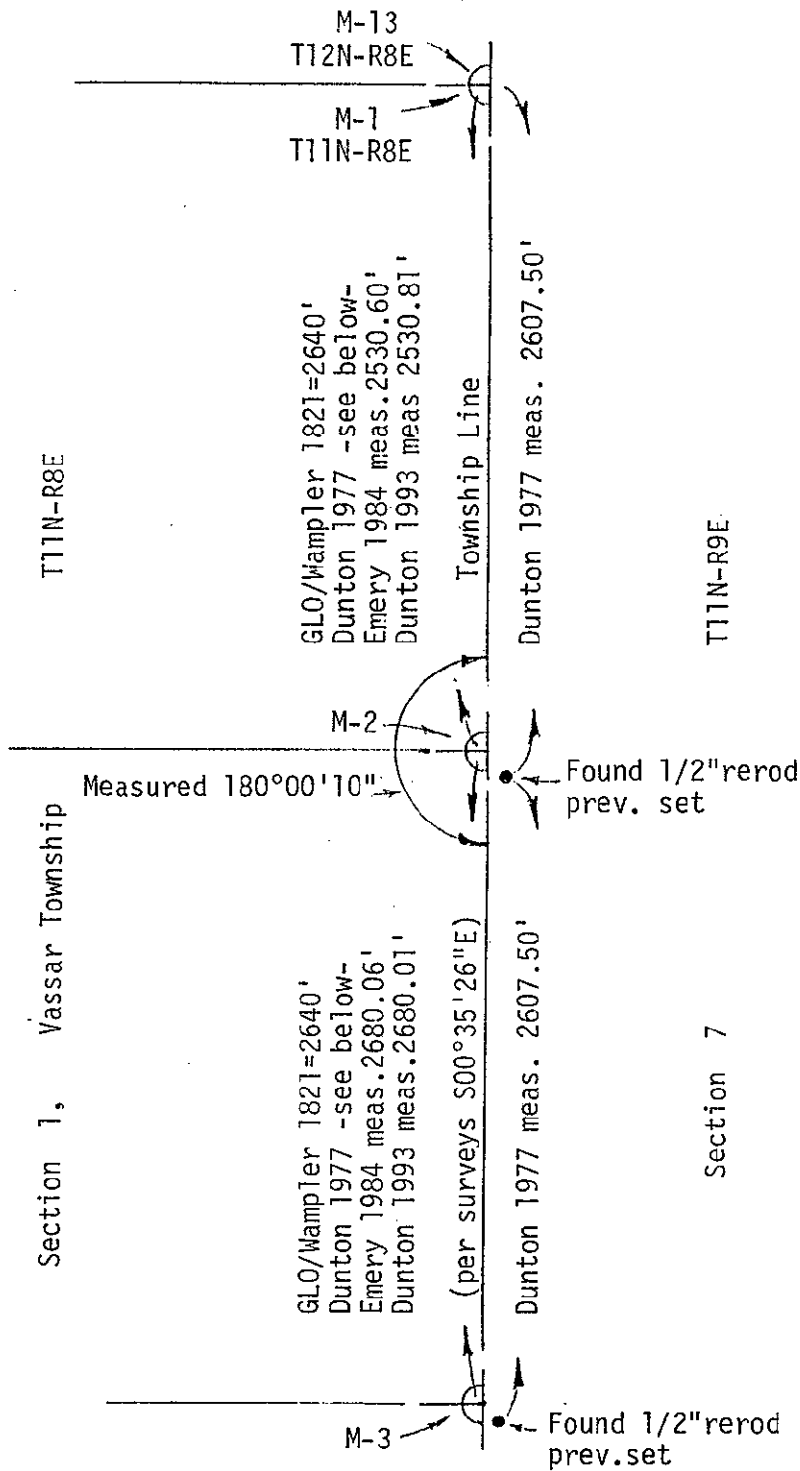

COPY