

SURVEY & REMONUMENTATION

DEC 02 1993

1993 REMONUMENTATION PROGRAM

LAND CORNER RECORDATION CERTIFICATE

Filing Requirement of Act 74, Mich. P.A. 1970

COMMISSION

For corners in

VASSAR TOWNSHIP

TUSCOLA

(County)

Located In:

Corner Code #

- | | | |
|---------------------------------------|--------------------------|------------|
| 1. Public Land Survey | T <u>11N</u> R <u>8E</u> | <u>M-8</u> |
| | T _____ R _____ | _____ |
| | T _____ R _____ | _____ |
| | T _____ R _____ | _____ |
| 2. Property Controlling in Section | S _____ T _____ R _____ | _____ |
| | S _____ T _____ R _____ | _____ |
| 3. Miscellaneous Property in Sec. | S _____ T _____ R _____ | _____ |
| | S _____ T _____ R _____ | _____ |
| 4. Lot No. _____, Recorded Plat _____ | | |
| 5. Private Claims _____ | | |

RECEIVED FOR RECORD
 VASSAR TOWNSHIP
 TUSCOLA COUNTY
 REGISTER OF DEEDS
 93 OCT 22 PM 2:43
 LIBER. NO. _____ PAGE NO. _____
 FILMING NO. #83

Register of Deeds Stamp & File Number

	A	B	C	D	E	F	G	H	I	J	K	L	M
2	6	5											
3													
4	7	8	9	10	11	12							
5													
6	18	17	16	15	14	13							
7													
8	19	20	21	22	23	24							
9													
10	30	29	28	27	26	25							
11													
12	31	32	33	34	35	36							
13													

I, KENNETH D. DUNTON, in a field survey on July 24, 1993, do hereby certify that under requirements of P.A. 74, Michigan P.A. of 1970, the corner points mentioned in lines 1 and 2 above were in conformance with regulations and rules therefore as required in the current manual of survey instructions of the United States Department of the Interior, Bureau of Land Management or by a decree of a Court of Law and/or that the corner points mentioned in lines 3, 4 and 5 above were in conformance with the rules of the Michigan Board of Land Surveyors or by a Decree of a Court of Law; established, re-established, monumented, re-monumented, recovered, found as expressed below:

NOTE: Not more than 4 corners, all in the same town and range, may be recorded on this certificate.

A. Description of original monument and accessories and/or subsequent restoration:

1821 G.L.O. Notes
 Joseph Wampler, D.S.
 Set 1/2 M. Post
 Beech 8" S73°W 3.3'
 Beech 13" N41°E 5.28'

April 8, 1898
 G. B. Felton, County Surveyor
 Set from measure
 Cedar post & small stones
 at corner. No accessories
 given. Measurements of 2605
 ft. to corners M-7 & M-9.

April 2, 1960
 R. J. Black, R.L.S. #3384
 Survey-unrecorded for James
 Churchill, Vassar, MI
 No accessories given.
 Measured 2605.5'
 Corner M-7 to M-8

NOTE: Section A. continued on back of form.

B. Description of corner evidence found and/or method applied in restoring or reestablishing corner:


& accepted
 Found 1 1/2" rod and cap #11192 next to large "T" iron - 18" deep.

C. Description of monument for corner and accessories established to perpetuate locating the position of the corner:

Set 4" x 36" concrete monument with 36" x 5/8" rod through center and 2" standard brass cap stamped corner M-8, T11N-R8E Placed monument box over monument.
 N81°48'W 28.09' set T.C. Re-mon. tag & spike in North face corner post.
 N54°38'W 33.92' set T.C. Re-mon. tag & spike in South face fence post.
 N16°42'E 104.80' South edge fiber post (Lakehead Pipeline Co.)
 N34°42'E 59.92' found rod & cap #24593
 N71°26'E 35.45' found rod & cap #24593
 N80°13'E 57.43' set T.C. Re-mon tag & spike in South face P. pole

COPY

Signed by Kenneth D. Dunton Date September 27, 1993
 Surveyor's Michigan License No. 23503

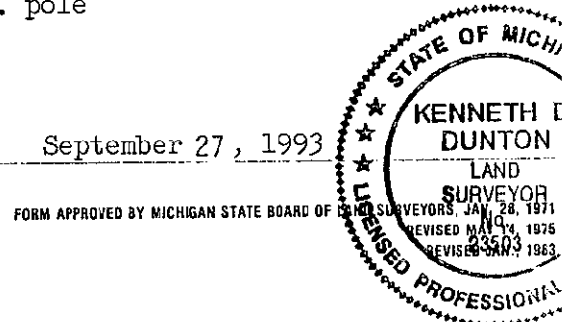

APPROVED
 9-27-93 *Jmt.*

