

DEC 02 1993

1993 REMONUMENTATION PROGRAM
LAND CORNER RECORDATION CERTIFICATE
Filing Requirement of Act 74, Mich. P.A. 1970
VASSAR TOWNSHIP

For corners in
TUSCOLA
(County)

Located In: Corner Code ##

- | | | |
|---------------------------------------|--------------------------|-------------|
| 1. Public Land Survey | T <u>11N</u> R <u>8E</u> | <u>M-11</u> |
| | T _____ R _____ | _____ |
| | T _____ R _____ | _____ |
| | T _____ R _____ | _____ |
| 2. Property Controlling in Section | S _____ T _____ R _____ | _____ |
| | S _____ T _____ R _____ | _____ |
| 3. Miscellaneous Property in Sec. | S _____ T _____ R _____ | _____ |
| | S _____ T _____ R _____ | _____ |
| 4. Lot No. _____, Recorded Plat _____ | | |
| 5. Private Claims _____ | | |

RECEIVED FOR RECORD
VASSAR TOWNSHIP
TUSCOLA COUNTY
REGISTER OF DEEDS
93 OCT 22 PM 2:43
LIBERATION NO. 710
PAGE NO. 80
FILING NO. #80

Register of Deeds Stamp & File Number

I, KENNETH D. DUNTON, in a field survey on July 17, 19 93, do hereby certify that under requirements of P.A. 74, Michigan P.A. of 1970, the corner points mentioned in lines 1 and 2 above were in conformance with regulations and rules therefore as required in the current manual of survey instructions of the United States Department of the Interior, Bureau of Land Management or by a decree of a Court of Law and/or that the corner points mentioned in lines 3, 4 and 5 above were in conformance with the rules of the Michigan Board of Land Surveyors or by a Decree of a Court of Law; established, re-established, monumented, re-monumented, recovered, found as expressed below:

A	B	C	D	E	F	G	H	I	J	K	L	M
2	6	5	4	3	2	1						
3												
4	7	8	9	10	11	12						
5												
6	18	17	16	15	14	13						
7												
8	19	20	21	22	23	24						
9												
10	30	29	28	27	26	25						
11												
12	31	32	33	34	35	36						
13												

NOTE: Not more than 4 corners, all in the same town and range, may be recorded on this certificate.

A. Description of original monument and accessories and/or subsequent restoration:

1821 G.L.O. Notes	March 17, 1892
Joseph Wampler, D.S.	County Surveyor's Records
Set Post Corner Sections 25 & 36	G.B. Felton, Surveyor
Beech 8" S50°W 8.58'	From B.T.
Birch 11" N3°E 10.56'	Beech 13" N48°W 32.01'
	Pine 20" N14½°W 112.53'

A. Continued on back of form.


B. Description of corner evidence found and/or method applied in restoring or reestablishing corner:

and accepted
Found "T" iron 24" deep & wood stake below.

C. Description of monument for corner and accessories established to perpetuate locating the position of the corner:

Set 4" x 36" concrete monument with 36" x 5/8" rod through center and 2" standard brass cap stamped corner M-11, T11N-R8E. Placed monument box over monument.
S47°06'W 35.21' West end 50' of 15" C.S.P. crossroad culvert
S43°16'E 34.54' East end 50' of 15" C.S.P. crossroad culvert
N43°34'W 47.62' T.C. Re-mon. tag & spike in SW face 6" corner post
N17°47'W 107.90' T.C. Re-mon. tag & spike over 11192 tag & nail in E. face p.
N50°46'E 145.52' T.C. Re-mon. tag & spike over 11192 tag & nail in S. face p.

Signed by Kenneth D. Dunton Date September 20, 1993
Surveyor's Michigan License No. 23503

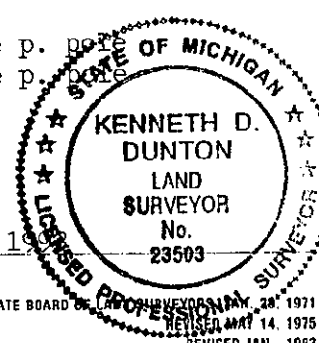

APPROVED

Continued from Section A on front of this form:

May 26, 1964

Witness card on file with Rowe Engineering, Caro.

Found wooden stake & perpetuated with 3/4" pipe,

by R. J. Black, R.L.S. #3384

N30°W 92.65' - 10" cedar

N70°W 102.00' - 14" cedar

N45°W 31.65' - 12" maple

Note: R. J. Black not associated with Rowe Engineering

April 24, 1971 Act 74, Vassar Township, Page 8

David T. Rowe, R.L.S. #11192 Found 1" pipe bent over & replaced with "T" iron.

N15°W 133.68' 18" cedar

N80°W 102.02' 18" cedar

S40°W 45.67' road sign post

N40°W 31.61' 18" cedar stump

November 8, 1972 Act 74, Vassar Township, Page 6

Stephen Soltis, Jr., R.L.S. #19007, Found 3/4" iron pipe agrees with witnesses obtained from Rowe Engineering Co.

N30°W 92.65' 10" cedar

N70°W 102.00' 14" cedar

S45°W 31.65' 12" maple (bearing should have been NW)

September 18, 1975 Survey, Liber 453, Page 486 by James A. Beck, R.L.S. #21559. No statement of object found or set.

May 5, 1978 Survey, Liber 487, Pages 1370 & 1371 by Kenneth D. Dunton, R.L.S. #23503. "T" iron.

N45°E 145.50' RLS 11192 tag in P.P.

N15°W 133.68' 18" tree (cedar w/nail & cap)

N20°W 93.0' face 18" cedar stump

N45°W 31.65' face 12" maple stump

September 6, 1978 Survey, Liber 491, Page 099

By Robert G. Kay, R.L.S. #14096. Found "T" iron.

N45°E 145.50' R.L.S. 11192 tag in P.P.

N20°W 93.0' face 18" cedar stump

N45°W 31.65' face 12" maple stump

N15°W 133.68' nail & cap 18" cedar

February 16, 1979 Survey, Liber 496, Pages 074 & 075

By David T. Rowe, R.L.S. #11192. Found "T" iron.

N15°W 133.68' 18" cedar tree (nail & cap)

N20°W 93.0' face 18" cedar stump

N80°W 102.02' 18" cedar stump

N45°W 31.65' face 12" maple stump

N45°W 31.65' face 12" maple stump

NORTH



No Scale

Note: Bearings shown along Township Line are NOT relative.

