

**SURVEY &
REMONUMENTATION**

OCT 20 1994

**LAND CORNER RECORDATION CERTIFICATE
COMMISSION**
Filing Requirement of Act 74, Mich. P.A. 1970
1994 REMONUMENTATION PROGRAM

For corners in **Fremont Twp.**
TUSCOLA
(County)

Located In:

Corner Code #

1. Public Land Survey	T 11N R 09E	A-13
	T _____ R _____	_____
	T _____ R _____	_____
	T _____ R _____	_____
2. Property Controlling in Section	S _____ T _____ R _____	_____
	S _____ T _____ R _____	_____
3. Miscellaneous Property in Sec.	S _____ T _____ R _____	_____
	S _____ T _____ R _____	_____

COPY

RECEIVED FOR RECORD
LIBER NO. _____ PAGE NO. _____
FILING NO. # 67
Fremont Twp
94 OCT 10 AM 8:49
VIRGINIA H. McLAVER
TUSCOLA COUNTY
REGISTER OF DEEDS

Register of Deeds Stamp & File Number

4. Lot No. _____, Recorded Plat _____
5. Private Claims _____

1	A	B	C	D	E	F	G	H	I	J	K	L	M
2	6	5	4	3	2	1							
3													
4	7	8	9	10	11	12							
5													
6	18	17	16	15	14	13							
7													
8	19	20	21	22	23	24							
9													
10	30	29	28	27	26	25							
11													
12	31	32	33	34	35	36							
13													

I, JONATHAN M. FIELD, in a field survey on JULY 14 19 94, do hereby certify that under requirements of P.A. 74, Michigan P.A. of 1970, the corner points mentioned in lines 1 and 2 above were in conformance with regulations and rules therefore as required in the current manual of survey instructions of the United States Department of the Interior, Bureau of Land Management or by a decree of a Court of Law and/or that the corner points mentioned in lines 3, 4 and 5 above were in conformance with the rules of the Michigan Board of Land Surveyors or by a Decree of a Court of Law; established, re-established, monumented, re-monumented, recovered, found as expressed below:

NOTE: Not more than 4 corners, all in the same town and range, may be recorded on this certificate.


A. Description of original monument and accessories and/or subsequent restoration:
1834 GLO; PARKE, D.S.; SET POST; BEECH 9 S61E 22LKS., BEECH 6 N76E 25LKS.
1993 CORNERSTONE; BONNO, P.S.#32332; SURVEY FOR TIMOTHY MCLEOD DATED 6-10-93; FND. T-IRON 2' DEEP - SET 1/2" ROD; EAST 32.38' RD SIGN, N78°E 58.6' STOP SIGN, N45°E, 159.50' P.POLE, S45°E 41.1' CORNER POST, S15°E 48.0' CORNER POST

B. Description of corner evidence found and/or method applied in restoring or reestablishing corner:
1994 ROWE ENG. - FIELD, P.S.#37276; FND 1/2" ROD OVER T-IRON (3' DEEP) 4' N. OF C/L - C/L OF ASPH. ROAD N-S AND GRAVEL ROAD E. 3 PREVIOUS WITNESSES INDICATE THAT 1/2" ROD IS IN SAME POSITION AS 1993 CORNERSTONE IRON

ACCEPTED 1/2" ROD AND T-IRON AS BEST EVIDENCE OF ORIGINAL CORNER POSITION

SEE ALSO BACK OF THIS FORM

C. Description of monument for corner and accessories established to perpetuate locating the position of the corner:
A-13 REMOVED ROD AND T-IRON, SET STANDARD MONUMENT (5/8"X36" ROD W/ BRASS CAP IN CONC, IN MON. BOX)
S57°E, 47.06' SET NAIL W/REMON TAG IN N. FACE 8"X8" FENCE POST
S23°E, 48.41' SET NAIL W/REMON TAG IN W. FACE 12" FENCE POST
WEST, 32.98' CENTER OF ROAD SIGN POST
N71°W, 111.83' SET NAIL W/REMON TAG IN S. FACE T.POLE
N45°E, 161.10' SET NAIL W/REMON TAG IN W. FACE T.POLE
N78°E, 58.6' S. EDGE OF STOP SIGN POST

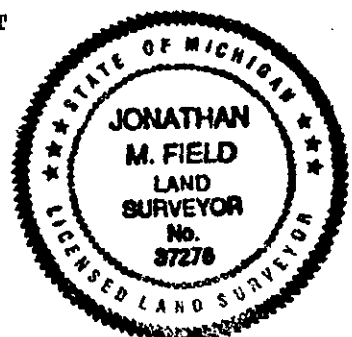

Signed by Jonathan M. Field Date 9-2-94
Surveyor's Michigan License No. 37276

APPROVED
8-31-94
KDD
J.M.F.

SEE ALSO 1993 REMONUMENTATION
L.C.R.C. 80

M-11
TIIN-R8E



WASHBURN ROAD



748.48'

89°51'43"

A-13
ON E. TWP.
LINE

M-12
TIIN-R8E


SEE ALSO 1993 REMONUMENTATION
L.C.R.C. 79

SEC 31
TIIN-R9E

1834 G.L.O. 2640'
1993 CORNERSTONE 2656.19'
1994 REI 2648.12'

BROWN ROAD

SEC 6
TION-R9E

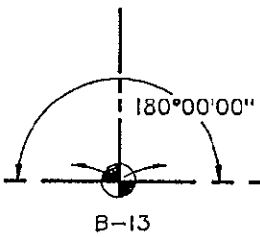

SEE ALSO 1994
REMONUMENTATION
L.C.R.C. FOR B-13