

SURVEY &
REMONUMENTATION

OCT 20 1994

LAND CORNER RECORDATION CERTIFICATE

Filing Requirement of Act 74, Mich. P.A. 1970
1994 REMONUMENTATION PROGRAM

COMMISSIONER

For corners in **Fremont Twp.**
TUSCOLA
(County)

Located In:

Corner Code #

- | | | |
|---------------------------------------|-------------|------|
| 1. Public Land Survey | T 11N R 09E | B-13 |
| | T R | |
| | T R | |
| | T R | |
| 2. Property Controlling
in Section | S T R | |
| | S T R | |
| 3. Miscellaneous
Property in Sec. | S T R | |
| | S T R | |

4. Lot No. _____, Recorded Plat _____
5. Private Claims _____

I, JONATHAN M. FIELD, in a field survey on JULY 14 1994, do hereby certify that under requirements of P.A. 74, Michigan P.A. of 1970, the corner points mentioned in lines 1 and 2 above were in conformance with regulations and rules therefore as required in the current manual of survey instructions of the United States Department of the Interior, Bureau of Land Management or by a decree of a Court of Law and/or that the corner points mentioned in lines 3, 4 and 5 above were in conformance with the rules of the Michigan Board of Land Surveyors or by a Decree of a Court of Law; established, re-established, monumented, re-monumented, recovered, found as expressed below:

NOTE: Not more than 4 corners, all in the same town and range, may be recorded on this certificate.

A. Description of original monument and accessories and/or subsequent restoration:
1834 GLO; PARKE, D.S.; SET POST; BEECH 16 N86E 15LKS., HEMLOCK 16 N80W 20LKS.
1993 CORNERSTONE; BONNO, P.S.#32332; SURVEY FOR TIMOTHY MCLEOD DATED 6-10-93; OBJECT NOT STATED; NO WITS GIVEN;


B. Description of corner evidence found and/or method applied in restoring or reestablishing corner:
1994 ROWE ENG. - FIELD, P.S.#37276; FND NO EVIDENCE OF MONUMENT AT CORNER

DID NOT ACCEPT PREVIOUS POSITION HELD BY CORNERSTONE SURVEYING IN 1993
ESTABLISHED CORNER POSITION BY SINGLE PROPORTION BETWEEN CORNERS A-13 AND C-13, T11N-R9E

SEE ALSO BACK OF THIS FORM

C. Description of monument for corner and accessories established to perpetuate locating the position of the corner:
B-13 SET STANDARD MONUMENT (5/8"X36" ROD W/ BRASS CAP IN CONC.)
S75°E, 46.71' SET 1/2" ROD
N13°E, 22.84' SET NAIL W/REMON TAG IN S. FACE FENCE POST
S35°E, 38.45' SET NAIL W/REMON TAG IN N. FACE 24" COTTONWOOD
S69°E, 89.09' SET NAIL W/REMON TAG IN N. FACE 34" MAPLE
N30°W, 157.76' SET NAIL W/REMON TAG IN SW FACE P. POLE
WEST, 10' C/L EXTENDED OF FENCE TO NORTH
SOUTH, 6.8' C/L GRAVEL ROAD E-W

Signed by Jonathan M. Field Date 9-2-94
Surveyor's Michigan License No. 37276

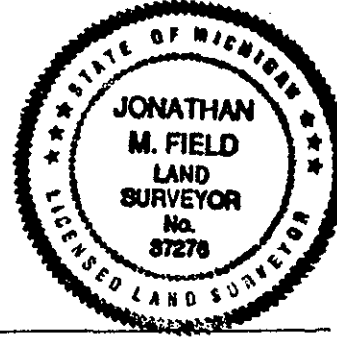

APPROVED
8-31-94
JMG
J.H.C.

RECEIVED FOR RECORD
LIBER NO. _____ PAGE NO. _____
FILING NO. # 68
FREMONT TWP.
94 OCT 10 AM 8:49
VIRGINIA H. MCLAREN
TUSCOLA COUNTY
REGISTER OF DEEDS
Register of Deeds Stamp & File Number

1	A	B	C	D	E	F	G	H	I	J	K	L	M
2	6		5		4		3		2		1		
3													
4	7		8		9		10		11		12		
5													
6	18		17		16		15		14		13		
7													
8	19		20		21		22		23		24		
9													
10	30		29		28		27		26		25		
11													
12	31		32		33		34		35		36		
13													

WASHBURN ROAD




CHAMBERS ROAD

SEC 31
T11N-R9E

1834 G.L.O. 2640'
1993 CORNERSTONE 2656.19'
1994 REI 2648.12'

1834 G.L.O. 2640'
1993 CORNERSTONE 2640.00'
1994 REI 2648.12'

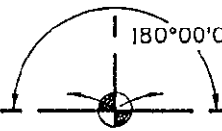

A-13
ON E. TWP.
LINE T11N-R8E

B-13
BROWN ROAD

C-13