

OCT 26 1994

LAND CORNER RECORDATION CERTIFICATE

Filing Requirement of Act 74, Mich. P.A. 1970
1994 REMONUMENTATION PROGRAM

COMMISSIONER

For corners in Fremont Twp.
TUSCOLA
(County)

Located In:

Corner Code #

COPY

REGISTER OF DEEDS
TUSCOLA COUNTY
FREMONT TWP
#74
OCT 10 AM 8:10

1. Public Land Survey	T 11N R 09E	H-13
	T R	
	T R	
	T R	
2. Property Controlling in Section	S T R	
	S T R	
3. Miscellaneous Property in Sec.	S T R	
	S T R	

Register of Deeds Stamp & File Number

4. Lot No. _____, Recorded Plat _____
5. Private Claims _____

	A	B	C	D	E	F	G	H	I	J	K	L	M
1													
2	6	5	4	3	2	1							
3													
4	7	8	9	10	11	12							
5													
6	18	17	16	15	14	13							
7													
8	19	20	21	22	23	24							
9													
10	30	29	28	27	26	25							
11													
12	31	32	33	34	35	36							
13													

I, JONATHAN M. FIELD, in a field survey on JULY 14 19 94 do hereby certify that under requirements of P.A. 74, Michigan P.A. of 1970, the corner points mentioned in lines 1 and 2 above were in conformance with regulations and rules therefore as required in the current manual of survey instructions of the United States Department of the Interior, Bureau of Land Management or by a decree of a Court of Law and/or that the corner points mentioned in lines 3, 4 and 5 above were in conformance with the rules of the Michigan Board of Land Surveyors or by a Decree of a Court of Law; established, re-established, monumented, re-monumented, recovered, found as expressed below:

NOTE: Not more than 4 corners, all in the same town and range, may be recorded on this certificate.


A. Description of original monument and accessories and/or subsequent restoration:
1834 GLO; PARKE, D.S.; SET POST; BEECH 8 N74W 20LKS., LYNN 15 N70E 49LKS.

B. Description of corner evidence found and/or method applied in restoring or reestablishing corner:
1994 ROWE ENG. - FIELD, P.S.#37276; FND NO EVIDENCE OF MONUMENT AT CORNER

RE-ESTABLISHED CORNER POSITION BY SINGLE PROPORTION BETWEEN CORNERS G-13 AND I-13, T11N-R9E

SEE ALSO BACK OF THIS FORM

C. Description of monument for corner and accessories established to perpetuate locating the position of the corner:
H-13 SET STANDARD MONUMENT (5/8"X36" ROD W/ BRASS CAP IN CONC., IN MON. BOX)
N 50°E, 24.27' SET 1/2" ROD W/ CAP #37276
S 50°E, 23.26' SET 1/2" ROD W/ CAP #37276
S 45°W, 21.58' SET 1/2" ROD W/ CAP #37276
N 45°W, 19.11' SET 1/2" ROD W/ CAP #37276
EAST, 18' C/L EXTENDED OF SINGLE STRAND ELECTRIC FENCE TO N.
SOUTH, 0.6' C/L ASPH. ROAD E-W

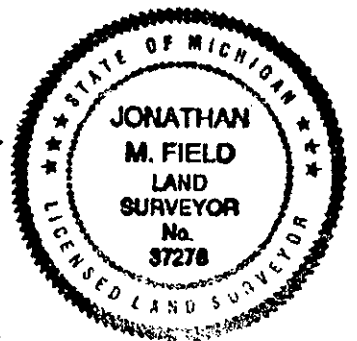

Signed by Jonathan M. Field Date 9-2-94
Surveyor's Michigan License No. 37276

APPROVED
8-24-94
[Signature]

CONRAD ROAD

SW 1/4
SEC 34
TIIN-R9E

SE 1/4
SEC 34
TIIN-R9E

MERTZ ROAD



179°54'43"

1834 GLO 2640'
1994 REI 2645.32'

180°00'00"

1834 GLO 2640'
1994 REI 2645.32'

G-13

H-13

I-13

BROWN ROAD