

SURVEY
REMONU

OCT 20 1994

COMM

LAND CORNER RECORDATION CERTIFICATE

Filing Requirement of Act 74, Mich. P.A. 1970

1994 REMONUMENTATION PROGRAM

For corners in Fremont Twp.
TUSCOLA
(County)

Located In:

Corner Code #

- 1. Public Land Survey T 11N R 09E
- T _____ R _____
- T _____ R _____
- T _____ R _____
- 2. Property Controlling S _____ T _____ R _____
- in Section S _____ T _____ R _____
- 3. Miscellaneous S _____ T _____ R _____
- Property in Sec. S _____ T _____ R _____

K-13

COPY

RECEIVED FOR RECORD
LIBER NO. _____ PAGE NO. _____
FILING NO. # 77
Fremont Twp.
94 OCT 10 AM 8:50
VIRGINIA H. McLAREN
TUSCOLA COUNTY
REGISTER OF DEEDS
Register of Deeds Stamp & File Number

- 4. Lot No. _____, Recorded Plat _____
- 5. Private Claims _____

I, JONATHAN M. FIELD, in a field survey on JULY 14 19 94, do hereby certify that under requirements of P.A. 74, Michigan P.A. of 1970, the corner points mentioned in lines 1 and 2 above were in conformance with regulations and rules therefore as required in the current manual of survey instructions of the United States Department of the Interior, Bureau of Land Management or by a decree of a Court of Law and/or that the corner points mentioned in lines 3, 4 and 5 above were in conformance with the rules of the Michigan Board of Land Surveyors or by a Decree of a Court of Law; established, re-established, monumented, re-monumented, recovered, found as expressed below:

NOTE: Not more than 4 corners, all in the same town and range, may be recorded on this certificate.

A. Description of original monument and accessories and/or subsequent restoration:
1834 GLO; PARKE, D.S.; SET POST; B.ASH 10 N48E 28LKS., ELM 6 N35W 25LKS.

B. Description of corner evidence found and/or method applied in restoring or reestablishing corner:
1994 ROWE ENG. - FIELD, P.S.#37276; FND R.R. SPIKE AT C/L ASPH ROAD E-W AND ON LINE WITH FENCE ROW TO N.

ACCEPTED R.R. SPIKE AS BEST EVIDENCE OF ORIGINAL CORNER POSITION

SEE ALSO BACK OF THIS FORM

C. Description of monument for corner and accessories established to perpetuate locating the position of the corner:
K-13 REMOVED R.R. SPIKE, SET STANDARD MONUMENT (5/8"X36" ROD W/ BRASS CAP IN CONC, IN MON BOX)
N09°E, 32.20' FND P-K NAIL W/FLAG IN W. FACE FENCE POST
N49°W, 24.67' SET 1/2" ROD
N54°E, 28.95' SET 1/2" ROD
S55°W, 24.81' SET 1/2" ROD
S59°E, 27.61' SET 1/2" ROD



Signed by Jonathan M. Field Date 9-2-94
Surveyor's Michigan License No. 37276


APPROVED
8-29-94
J.M.F.
L.P.C.



SE 1/4
SEC 35
TIIN-R9E

SW 1/4
SEC 36
TIIN-R9E

SCHOTT ROAD

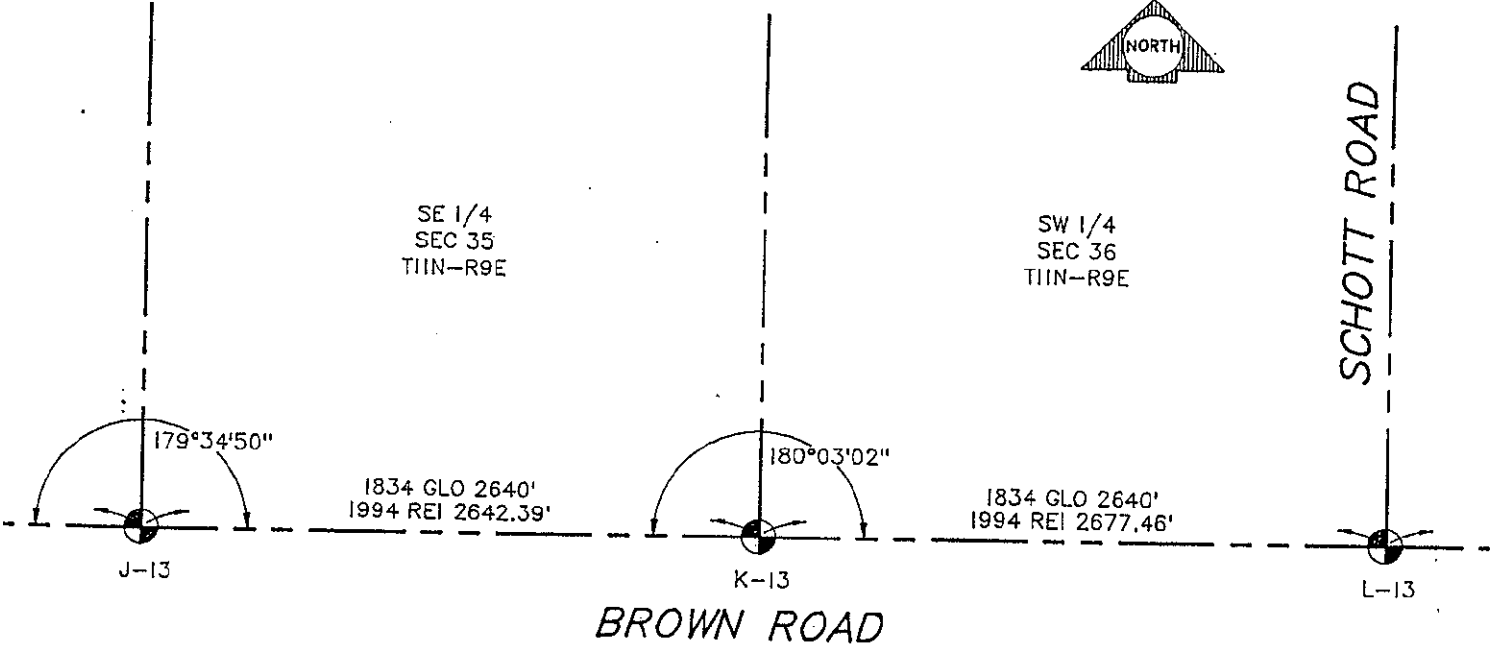

J-13

K-13

L-13

BROWN ROAD

