SURVEY &
REMONUMENTATION

OCT 20 1994

COMMISSION

LAND CORNER RECORDATION CERTIFICATE

Filing Requirement of Act 74, Mich. P.A. 1970
1994 REMONUMENTATION PROGRAM

COPY

RECEIVED FOR RECORD
LIBER NO. ____ PAGE NO. ____
FILING NO. Fremont Twp. # 78
94 OCT 10 AM 8:50
VIRGINIA H. McLAREN
TUSCOLA COUNTY
REGISTER OF DEEDS

Register of Deeds Stamp & File Number

For corners in Fremont Twp.
TUSCOLA (County) Located In: Corner Code #

1. Public Land Survey		T 11N	R 09E	L-13
		T	R	
		T	R	
		T	R	
2. Property Controlling	S	T	R	
in Section	S	T	R	
3. Miscellaneous	S	T	R	
Property in Sec.	S	T	R	

4. Lot No. _____, Recorded Plat _____
5. Private Claims _____

	A	B	C	D	E	F	G	H	I	J	K	L	M
1													
2		6		5		4		3		2		1	
3													
4		7		8		9		10		11		12	
5													
6		18		17		16		15		14		13	
7													
8		19		20		21		22		23		24	
9													
10		30		29		28		27		26		25	
11													
12		31		32		33		34		35		36	
13													

I, JONATHAN M. FIELD, in a field survey on JULY 14 19 94, do hereby certify that under requirements of P.A. 74, Michigan P.A. of 1970, the corner points mentioned in lines 1 and 2 above were in conformance with regulations and rules therefore as required in the current manual of survey instructions of the United States Department of the Interior, Bureau of Land Management or by a decree of a Court of Law and/or that the corner points mentioned in lines 3, 4 and 5 above were in conformance with the rules of the Michigan Board of Land Surveyors or by a Decree of a Court of Law; established, re-established, monumented, re-monumented, recovered, found as expressed below;

NOTE: **Not more than 4 corners, all in the same town and range, may be recorded on this certificate.**

A. Description of original monument and accessories and/or subsequent restoration:
1834 GLO; PARKE, D.S.; SET POST; BEECH 12 N22W 20LKS., BEECH 14 N61E 48LKS.
1970 ROWE ENG.; SURVEY NOTES JOB NO. C-0074-70 & WIT CARD; FND RE-ROD; N35°W 56.75' D/H NAIL IN P.POLE, N20°W 118.30' NAIL P.POLE, N75°E 66.08' RD. SIGN; S10°E 13.2' E LEG SIGN, S02°W 12.94' W LEG SIGN, S50°W 74.85' NAIL IN P.POLE
1973 ROWE, P.S.#11192; LCRC 24; FND RE-ROD; 3 WITS GIVEN ARE SAME AS 1970 SURVEY NOTES ABOVE

B. Description of corner evidence found and/or method applied in restoring or reestablishing corner:
1994 ROWE ENG. - FIELD, P.S.#37276; FND 5/8" ROD ABOVE 1/2" SEAMED PIPE (30" DEEP) AT C/L ASPH ROAD E-W & ON C/L EXT. OF ASPH ROAD TO N. 2 PREVIOUS WITNESSES INDICATE THAT 5/8" ROD IS IN SAME POSITION AS 1970 ROWE ENG. IRON

ACCEPTED 5/8" ROD AND 1/2" PIPE AS BEST EVIDENCE OF ORIGINAL CORNER POSITION

SEE ALSO BACK OF THIS FORM

C. Description of monument for corner and accessories established to perpetuate locating the position of the corner:
L-13 REMOVED 5/8" ROD, SET STANDARD MONUMENT (5/8"X36" ROD W/ BRASS CAP IN CONC., IN MON BOX) ABOVE 1/2" PIPE

N56°E, 66.92' TOP CENTER OF PHONE RISER
N58°E, 60.99' CENTER OF ROAD SIGN POST
S67°E, 92.72' SET NAIL W/REMON TAG IN W. FACE 30" MAPLE
S29°E, 13.04' E. EDGE OF E. SIGN POST LEG
S60°W, 71.49' FND P-K NAIL W/TAG #20709 IN SE FACE T.POLE
N33°W, 57.13' FND P-K NAIL W/TAG #20709 IN SW FACE P.POLE
N20°W, 117.35' FND P-K NAIL W/TAG #20709 IN E. FACE T.POLE

STATE OF MICHIGAN
JONATHAN M. FIELD
LAND SURVEYOR
No. 37276
LICENSED LAND SURVEYOR

Signed by Jonathan M Field Date 9-2-94
Surveyor's Michigan License No. 37276

FORM APPROVED BY MICHIGAN STATE BOARD OF LAND SURVEYORS, JAN. 28, 197
REVISED MAY 14, 197
REVISED JAN., 198
ADAPTED FOR WORD PROCESSING MARCH, 199

APPROVED
8-29-94

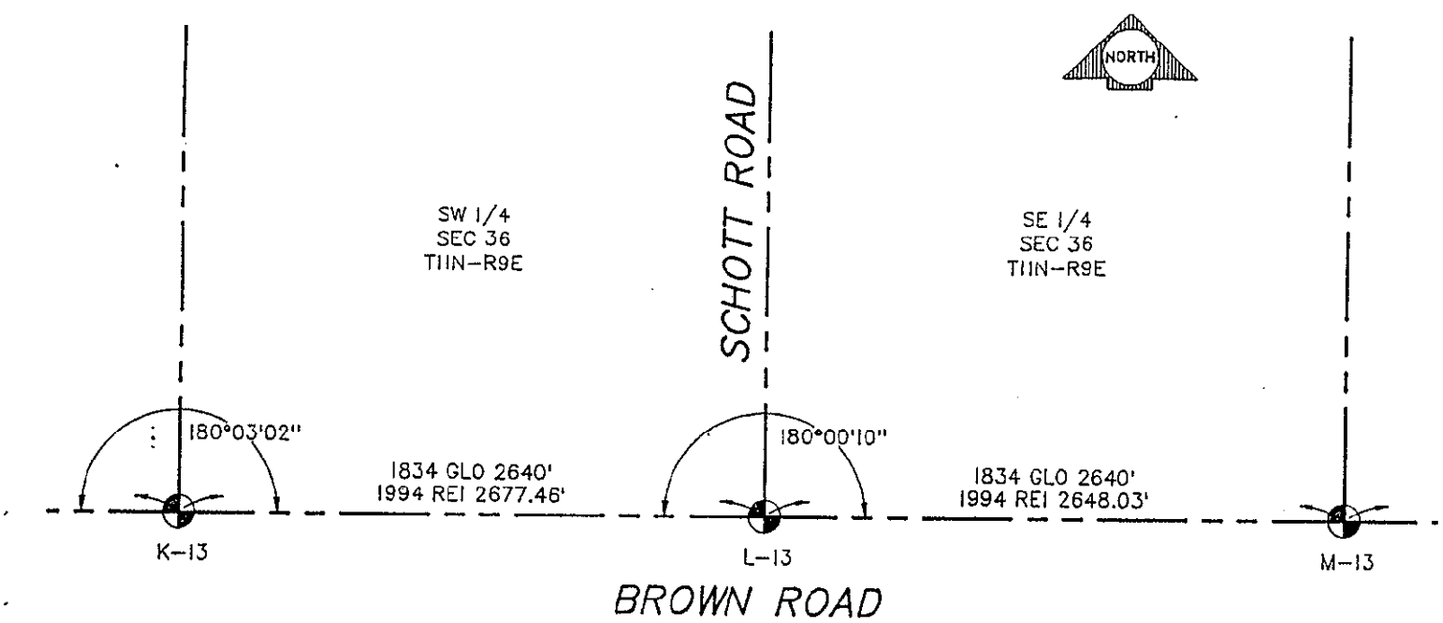
NORTH
SCHOTT ROAD
SW 1/4
SEC 36
T11N-R9E
SE 1/4
SEC 36
T11N-R9E
180°03'02"
180°00'10"
1834 GLO 2640'
1994 REI 2677.46'
1834 GLO 2640'
1994 REI 2648.03'
K-13
L-13
M-13
BROWN ROAD