

1996 REMONUMENTATION PROGRAM
 LAND CORNER RECORDATION CERTIFICATE
 Filing Requirement of Act 74, Mich. P.A. 1970

For corners in Fremont Twp.

Tuscola Located In: Corner Code #
 (County)

1. Public Land Survey T11N R 9E M-4
 T R
 T11N R10E A-4
 T R

2. Property Controlling S T R
 in Section S T R

3. Miscellaneous S T R
 Property in Sec. S T R

RECEIVED FOR RECORD
 LIBER NO. _____ PAGE NO. 83
 FILE NO. Fremont
 96 DEC 10 PM 4:47
 TUSCOLA COUNTY
 REGISTER OF DEEDS

Register of Deeds Stamp & File Number

4. Lot No. _____, Recorded Plat _____
 5. Private Claims _____

I, Kenneth D. Dutton, in a field survey on Apr. 21, 1996 do hereby state that under requirements of P.A. 74, Michigan P.A. of 1970, the corner points mentioned in lines 1 and 2 above were in conformance with regulations and rules therefore as required in the current manual of survey instructions of the United States Department of the Interior, Bureau of Land Management or by a decree of a Court of Law and for that the corner points mentioned in lines 3, 4 and 5 above were in conformance with the rules of the Michigan Board of Land Surveyors or by a Decree of a Court of Law, established, re-established, monumented, recovered, found as expressed below:

NOTE: Not more than 2 corners, all in the same town and range, may be recorded on this certificate.

	A	B	C	D	E	F	G	H	I	J	K	L	M
1													
2	6		5		4		3		2		1		
3													
4	7		8		9		10		11		12		
5													
6	18		17		16		15		14		13		
7													
8	19		20		21		22		23		24		
9													
10	30		29		28		27		26		25		
11													
12	31		32		33		34		35		36		
13													

A. Description of original monument and accessories and/or subsequent restoration:

G.L.O. 1834 May 17, 1955 Liber 2 of Plats on Page 10, Plat of
 Harvey Parke, D.S. Spee's Cat Lake Subd. by Roscoe J. Black, Land
 Set Quarter Section Post Surveyor #3384
 Birch 14 S3W 24 No mention of evidence found or set, plat mon.
 Cedar 12 N33W 26 S88°31'E 33'
 Aug. 7, 1973 Survey by David T. Rowe, Land Surveyor
 #11192, Liber 435-Page 675 No mention of object
 found or set or accessories.

B. Description of corner evidence found and/or method applied in restoring or reestablishing corner.


Found 1/2" re-rod. Accepted found rod as the best evidence of the original corner.

C. Description of monument for corner and accessories established to perpetuate locating the position of the corner:

Removed 1/2" rod and placed standard monument stamped corner M-4, T11N-R9E.
 Placed monument box over monument.
 N89°50'W 33.02' fnd. 1/2" pipe.
 N32°W 63.74' set remon. tag & spike in SW face P. pole.
 N56°E 67.35' set remon. tag & spike in NW face P. pole.
 N89°57'E 33.04' fnd. 1 1/2" pipe at apparent plat corner.

Note: This corner is common with A-4, T11N-R10E.

Signed by [Signature] Date 11-6-96
 Surveyor's Michigan License No. 23503

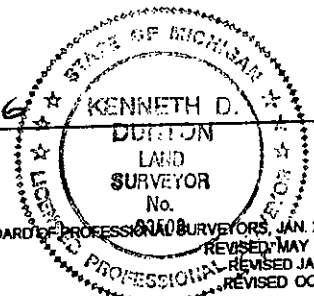

APPROVED
 11-6-96

FORM APPROVED BY MICHIGAN STATE BOARD OF PROFESSIONAL SURVEYORS, JAN. 28, 1971
 REVISED MAY 14, 1975
 REVISED JAN., 1983
 REVISED OCT., 1996

MAY 20 1997

COMMUNITY

23503

July 26, 1973

Survey by David T. Rowe, Land Surveyor #11192, Liber 443-Page 284
No mention of object found or set or accessories.

July 22, 1975

Survey by James A. Beck, Land Surveyor #21559, Liber 452-Page 586
Fnd. 5/8" re-rod.

- N20°E 93.15' RLS 11192 tag in 10" Maple.
- N55°E 96.50' RLS 11192 tag in 12" Maple.
- N85°E 75.62' RLS 11192 tag in 15" Maple.
- S35°E 100.07' RLS 11192 tag in 15" Maple.
- East 32.90' to re-rod inside 1 1/2" pipe.

Nov. 3, 1975

Survey by David T. Rowe, Land Surveyor #11192, Liber 458-Page 218
No mention of object found or set or accessories.

May 5, 1981 T.C.R.C. witness card Joe Male and Dick Griffis

- N20°E 93.16' 11192 tag in 20" Box Elder.
- N80°E 90.08' S.W. corner of garage, white siding.
- N60°W 36.54' top South end of 12" D/W culvert.

March 9, 1990

L.C.R.C. form filed by Paul N. Brown, Land Surveyor #33134 on Page 51, Dayton Township.

Fnd. 1/2" rod and raised with rod & cap #33134.

- East 33.04' fnd. 1 1/2" pipe.
- West 33.04' fnd. old 1/2" pipe.
- N20°E 93.45' set nail/tag #11192 in W. face triple 10" Box Elder.
- N30°W 79.13' set nail/tag #11192 in E. face 8" Maple.

March 13, 1990

Survey by Paul N. Brown, Land Surveyor #33134, Liber 602-Pages 1345 & 1346.
Same object and accessories as L.C.R.C. #51, Dayton Township.

Oct. 8, 1991

Survey by Russell L. Brown #24588, Liber 618-Pages 801 & 802

- Fnd. "T" iron.
- West 33.0' 1/2" pipe.
- N45°W 33.30' notch in South end 12" C.M.P.
- N30°E 68.50' 1/2" iron.

