

1996 REMONUMENTATION PROGRAM

LAND CORNER RECORDATION CERTIFICATE
Filing Requirement of Act 74, Mich. P.A. 1970

For corners in Dayton Twp.

Tuscola Located in: Corner Code #
(County)

- | | | |
|------------------------------------|--|------------|
| 1. Public Land Survey | T <u>11</u> N <u>R</u> <u>10</u> E | <u>A-3</u> |
| | T <u> </u> R <u> </u> | <u>M-3</u> |
| | T <u>11</u> N R <u>9</u> E | <u> </u> |
| | T <u> </u> R <u> </u> | <u> </u> |
| 2. Property Controlling in Section | S <u> </u> T <u> </u> R <u> </u> | <u> </u> |
| | S <u> </u> T <u> </u> R <u> </u> | <u> </u> |
| 3. Miscellaneous Property in Sec. | S <u> </u> T <u> </u> R <u> </u> | <u> </u> |
| | S <u> </u> T <u> </u> R <u> </u> | <u> </u> |

4. Lot No. _____, Recorded Plat _____
5. Private Claims _____

I, Kenneth D. Dunton in a field survey on Apr. 21, 1996 do hereby state that under requirements of P.A. 74, Michigan P.A. of 1970, the corner points mentioned in lines 1 and 2 above were in conformance with regulations and rules therefore as required in the current manual of survey instructions of the United States Department of the Interior, Bureau of Land Management or by a decree of a Court of Law and/or that the corner points mentioned in lines 3, 4 and 5 above were in conformance with the rules of the Michigan Board of Land Surveyors or by a Decree of a Court of Law; established, re-established, monumented, recovered, found as expressed below:

NOTE: Not more than 2 corners, all in the same town and range, may be recorded on this certificate.

	A	B	C	D	E	F	G	H	I	J	K	L	M
1													
2	6		5		4		3		2		1		
3													
4	7		8		9		10		11		12		
5													
6	10		17		16		15		14		13		
7													
8	19		20		21		22		23		24		
9													
10	30		29		28		27		26		25		
11													
12	31		32		33		34		35		36		
13													

A. Description of original monument and accessories and/or subsequent restoration:

G.L.O. 1834	Aug. 9, 1891.	Jan. 26, 1950
Harvey Parke, D.S.	G.B. Felton, Co. Surveyor	Plat of Cat Lake Subd., Liber 1
Set Post Corner	Survey Sec. 6 T11N-R10E,	of Plats on Page 100 now 50B
Secs. 1 & 12	North 1/2	by Winford G. Scott, Land
Hemlock 9 S20W 31	Set from B.T.'s	Surveyor #4002.
Hemlock 9 N69W 5 1/2	Hemlock 9 S20W 31	No mention of object found or
Corner M-3, T11N-R9E	Hemlock 9 N69W 5 1/2	set or accessories.

Note: Section A continued on back of form.

B. Description of corner evidence found and/or method applied in restoring or reestablishing corner:

Found 1/2" rod & "T" iron 15" deep - accepted as the best evidence of the original corner.


C. Description of monument for corner and accessories established to perpetuate locating the position of the corner:

Removed 1/2" rod & "T" iron and placed standard monument stamped corner M-3, T11N-R9E. Placed monument box over monument.
S89°W 33.56' set remon. tag in N. face cor. post.
N46°E 48.65' set remon. tag in NW face T.P. stub.
N66°E 63.94' set remon. tag in S. face 10" Pine.
S61°E 49.71' set remon. tag in N. face of W. leg sign.

Note: This corner is common with M-3, T11N-R9E.

Signed by [Signature]
Surveyor's Michigan License No. 23503

Date 11-6-96

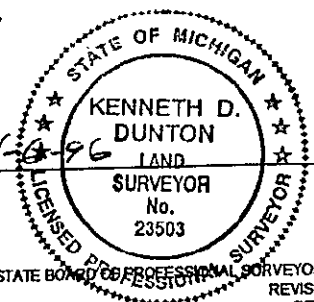

APPROVED
11-6-96

FORM APPROVED BY MICHIGAN STATE BOARD OF PROFESSIONAL SURVEYORS, JAN. 28, 1971
REVISED MAY 14, 1975
REVISED JAN., 1983
REVISED OCT., 1995

SURVEYOR
REMONUMENTATION

MAY 20 1997

COMMISSIONER

26

June 27, 1956

Plat of Cat Lake Hills, Liber 2 of Plats on Page 18 by Roscoe J. Black,
Land Surveyor #3384

No mention of object found or set or accessories.

July, 1972 L.C.R.C. form filed by David T. Rowe, Land Surveyor #11192 on
Page 23, Fremont Township.

Found 5/8" re-rod 8" deep, perpetuated with "T" iron.

N60°E 65.84' nail & tag in 8" Maple.

S41°E 36.35' nail & tag in 10" cor. post.

S55°W 78.63' nail & tag in P.P.

Aug. 7, 1973

Survey by David T. Rowe, Land Surveyor #11192, Liber 435-Page 675

No mention of object found or set or accessories.

Aug. 21, 1973

Survey by David T. Rowe, R.L.S. #11192, Liber 443-Pages 284 & 285.

No mention of object found or set or accessories.

June 28, 1974

Survey by David T. Rowe, Land Surveyor #11192, Liber 445-Pages 777 & 778.

No mention of object found or set or accessories.

July 22, 1975

Survey by James A Beck, Land Surveyor #21559, Liber 452-Page 586

"T" iron.

S88°W 23.03' RLS 11192 disc in fence post.

S40°E 36.38' nail & disc in fence post.

S35°W 78.62' nail & disc in P.P.

