

**1996 REMONUMENTATION PROGRAM
LAND CORNER RECORDATION CERTIFICATE
Filing Requirement of Act 74, Mich. P.A. 1970**

For corners in Dayton Twp.

<u>Tuscola</u> (County)	Located In:	Corner Code #
1. Public Land Survey	T <u>11</u> N R <u>10</u> E	<u>A-4</u> ✓
	T <u> </u> R <u> </u>	<u>M-4</u>
	T <u>11</u> N R <u>9</u> E	<u> </u>
	T <u> </u> R <u> </u>	<u> </u>
2. Property Controlling in Section	S <u> </u> T <u> </u> R <u> </u>	<u> </u>
	S <u> </u> T <u> </u> R <u> </u>	<u> </u>
3. Miscellaneous Property in Sec.	S <u> </u> T <u> </u> R <u> </u>	<u> </u>
	S <u> </u> T <u> </u> R <u> </u>	<u> </u>

REGISTER OF DEEDS STAMP & FILE NUMBER

RECEIVED FOR RECORD
LIBER NO. _____ PAGE NO. 76
FILE NO. Dayton
96 DEC 10 PM 4:49
Joseph J. [unclear]
TUSCOLA COUNTY
REGISTER OF DEEDS

4. Lot No. _____, Recorded Plat _____
5. Private Claims _____

I, Kenneth D. Dunton, in a field survey on Apr. 21, 1996 do hereby state that under requirements of P.A. 74, Michigan P.A. of 1970, the corner points mentioned in lines 1 and 2 above were in conformance with regulations and rules therefore as required in the current manual of survey instructions of the United States Department of the Interior, Bureau of Land Management or by a decree of a Court of Law and /or that the corner points mentioned in lines 3, 4 and 5 above were in conformance with the rules of the Michigan Board of Land Surveyors or by a Decree of a Court of Law; established, re-established, monumented, recovered, found as expressed below:

NOTE: Not more than 2 corners, all in the same town and range, may be recorded on this certificate.

A	B	C	D	E	F	G	H	I	J	K	L	M
1												
2	6		5		4		3		2		1	
3												
4	7		8		9		10		11		12	
5												
6	10		17		16		15		14		13	
7												
8	19		20		21		22		23		24	
9												
10	30		29		28		27		26		25	
11												
12	31		32		33		34		35		36	
13												

A. Description of original monument and accessories and/or subsequent restoration:

G.L.O. 1834 Harvey Parke, D.S. Set Quarter Section Post Birch 14 S3W 24 Cedar 12 N33W 26 Corner M-4, T11N-R9E	May 17, 1955 Liber 2 of Plats on Page 10, Plat of Spee's Cat Lake Subd. by Roscoe J. Black, Land Surveyor #3384 No mention of evidence found or set, plat mon. S88°31'E 33' Aug. 7, 1973 Survey by David T. Rowe, Land Surveyor #11192, Liber 435-Page 675 No mention of object found or set or accessories.
--	---

Section A continued on back of form.

B. Description of corner evidence found and/or method applied in restoring or reestablishing corner:

Found 1/2" re-rod. Accepted found rod as the best evidence of the original corner.


C. Description of monument for corner and accessories established to perpetuate locating the position of the corner:

Removed 1/2" rod and placed standard monument stamped corner M-4, T11N-R9E.
Placed monument box over monument.
N89°50'W 33.02' fnd. 1/2" pipe.
N32°W 63.74' set remon. tag & spike in SW face P. pole.
N56°E 67.35' set remon. tag & spike in NW face P. pole.
N89°57'E 33.04' fnd. 1 1/2" pipe at apparent plat corner.

Note: This corner is common with M-4, T11N-R9E.

Signed by *Kenneth D. Dunton*
Surveyor's Michigan License No. 23503

Date 11-6-96

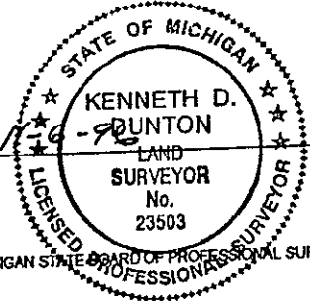

APPROVED
11-6-96
[Signatures]

REMONUMENTATION
MAY 29 1997
COMMISSIONER

FORM APPROVED BY MICHIGAN STATE BOARD OF PROFESSIONAL SURVEYORS, JAN. 28, 1971
REVISED MAY 14, 1975
REVISED JAN., 1983
REVISED OCT., 1995

July 26, 1973
Survey by David T. Rowe, Land Surveyor #11192, Liber 443-Page 284
No mention of object found or set or accessories.

July 22, 1975
Survey by James A. Beck, Land Surveyor #21559, Liber 452-Page 586
Fnd. 5/8" re-rod.
N20°E 93.15' RLS 11192 tag in 10" Maple.
N55°E 96.50' RLS 11192 tag in 12" Maple.
N85°E 75.62' RLS 11192 tag in 15" Maple.
S35°E 100.07' RLS 11192 tag in 15" Maple.
East 32.90' to re-rod inside 1 1/2" pipe.

Nov. 3, 1975
Survey by David T. Rowe, Land Surveyor #11192, Liber 458-Page 218
No mention of object found or set or accessories.

May 5, 1981 T.C.R.C. witness card Joe Male and Dick Griffis
N20°E 93.16' 11192 tag in 20" Box Elder.
N80°E 90.08' S.W. corner of garage, white siding.
N60°W 36.54' top South end of 12" D/W culvert.

March 9, 1990
L.C.R.C. form filed by Paul N. Brown, Land Surveyor #33134 on Page 51, Dayton Township.
Fnd. 1/2" rod and raised with rod & cap #33134.
East 33.04' fnd. 1 1/2" pipe.
West 33.04' fnd. old 1/2" pipe.
N20°E 93.45' set nail/tag #11192 in W. face triple 10" Box Elder.
N30°W 79.13' set nail/tag #11192 in E. face 8" Maple.

March 13, 1990
Survey by Paul N. Brown, Land Surveyor #33134, Liber 602-Pages 1345 & 1346.
Same object and accessories as L.C.R.C. #51, Dayton Township.

Oct. 8, 1991
Survey by Russell L. Brown #24588, Liber 618-Pages 801 & 802
Fnd. "T" iron.
West 33.0' 1/2" pipe.
N45°W 33.30' notch in South end 12" C.M.P.
N30°E 68.50' 1/2" iron.

