

**1996 REMONUMENTATION PROGRAM
LAND CORNER RECORDATION CERTIFICATE
Filing Requirement of Act 74, Mich. P.A. 1970**

For corners in Dayton Twp.

<u>Tuscola</u> (County)	Located In:	Corner Code #
1. Public Land Survey	T11N R 10E	<u>A-6</u>
	T R	
	T11W R 9E	<u>M-6</u>
	T R	
2. Property Controlling in Section	S T R	
	S T R	
3. Miscellaneous Property in Sec.	S T R	
	S T R	

RECEIVED FOR RECORD
LIBER NO. _____ PAGE NO. 74
FILE NO. Dayton
96 DEC 10 PM 4:49
TUSCOLA COUNTY
REGISTER OF DEEDS
[Signature]

Register of Deeds Stamp & File Number

4. Lot No. _____, Recorded Plat _____
5. Private Claims _____

I, Kenneth D. Durion, in a field survey on Apr. 21, 1996 do hereby state that under requirements of P.A. 74, Michigan P.A. of 1970, the corner points mentioned in lines 1 and 2 above were in conformance with regulations and rules therefore as required in the current manual of survey instructions of the United States Department of the Interior, Bureau of Land Management or by a decree of a Court of Law and/or that the corner points mentioned in lines 3, 4 and 5 above were in conformance with the rules of the Michigan Board of Land Surveyors or by a Decree of a Court of Law; established, re-established, monumented, recovered, found as expressed below:

A	B	C	D	E	F	G	H	I	J	K	L	M
1												
2	6		5		4		3		2		1	
3												
4	7		8		9		10		11		12	
5												
6	18		17		16		15		14		13	
7												
8	19		20		21		22		23		24	
9												
10	30		29		28		27		26		25	
11												
12	31		32		33		34		35		36	
13												

NOTE: Not more than 2 corners, all in the same town and range, may be recorded on this certificate.

A. Description of original monument and accessories and/or subsequent restoration:

G.L.O. Notes 1834	April 25, 1891
Harvey Parke, D.S.	G. B. Felton, County Surveyor
Set Quarter Section Post	Sec. 13 T11N-R9E
Beech 16 N3W 30	Set from measurements
Beech 9 S 1 1/2 W 29	Apple 4 N 35 1/4 W 198
Corner M-6, T11N-R9E	Popple 10 S 10 1/2 W 234

Note: Section A continued on back of form.

B. Description of corner evidence found and/or method applied in restoring or reestablishing corner:

Found 3/4" iron rod ^{with stone below,} 5' + North of E-W pavement centerline. Accepted found stone & iron as the best evidence of the original corner.


C. Description of monument for corner and accessories established to perpetuate locating the position of the corner:

Removed iron rod and placed standard monument stamped M-6, T11N-R9E. Placed monument box over monument.
 S15°W 93.99' set remon. tag & spike in South face T. pole stub.
 S38°W 57.96' fnd. P.K. nail in NW face cor. post. Set remon. tag & spike.
 N26°W 53.43' chiseled notch atop W. end 15" C.S.P.
 N44°E 62.55' set remon. tag & spike in NW face P. pole.
 S41°E 50.97' fnd. P.K. nail in NE face P. pole. Set remon. tag & spike.

Note: This corner is common with M-6, T11N-R9E.

Signed by [Signature]
Surveyor's Michigan License No. 23503

Date 11-6-96

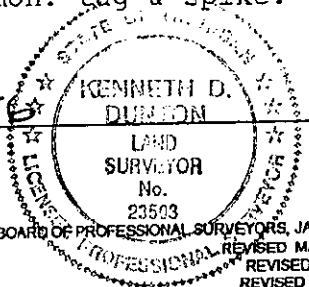

APPROVED
11-6-96
[Signatures]

FORM APPROVED BY MICHIGAN STATE BOARD OF PROFESSIONAL SURVEYORS, JAN. 28, 1971
REVISED MAY 14, 1975
REVISED JAN., 1983
REVISED OCT., 1985

REMONUMENT
MAY 2 1997
COMPL.

Sept. 13, 1971
 Survey by Robert G. Kay, Land Surveyor #14096, Liber 1-Pages 165 & 166.
 No mention of object found or set.
 N45°W 48.8' T.P.
 N45°E 42.8' road sign post
 S45°E 51.4' P.P.

Jan. 14, 1974
 Survey by Robert G. Kay, Land Surveyor #14096, Liber 437-Pages 278 & 279.
 Same accessories as L-1, P-165 & 166.

May 9, 1977
 Survey by James A. Beck, Land Surveyor #21559, Liber 472-Page 358.
 Same accessories as L-437, Pages 278 & 279.

May 26, 1981 Witness card from T.C.R.C. by K. D. Dunton, L.S. #23503.
 Re-set from Kay Eng. & Beck surveys. No mention of object set.
 N45°W 50.2' P.K. in T.P.
 S45°E 51.0' P.K. in P.P.
 S45°W 57.65' P.K. in Cor. Post.

April 16, 1984
 Survey by Harold N. Elrich, Land Surveyor #18986, Liber 541-Page 1466.
 S45°E 50.98' P.K. nail & ribbon in P.P.
 S45°W 57.65' P.K. nail & ribbon in corner post.
 Fnd. 5/8" iron rod.

March 5, 1987
 Survey by Earl E. Gravlin, Land Surveyor #23510, Liber 571-Page 445
 S45°E 51.0' P.P.
 S50°W 55.56' Rd. sign.
 N45°E 62.6' P.P.
 Fnd. nail

April 13, 1989
 Survey by Harold N. Elrich, Land Surveyor #18986, Liber 593-Page 12
 Same accessories and object as Liber 541, Page 1466.
 Also N50°E 62.57' P.K. nail in P.P.

