

1996 REMONUMENTATION PROGRAM
LAND CORNER RECORDATION CERTIFICATE
 Filing Requirement of Act 74, Mich. P.A. 1970

For corners in Dayton Township
Tuscola
(County)

Located In: _____ Corner Code A-7

- | | | |
|------------------------------------|-----------------------------|--------------|
| 1. Public Land Survey | T <u>11</u> N R <u>10</u> E | <u>A-7</u> ✓ |
| | T _____ R _____ | _____ |
| | T <u>11</u> N R <u>9</u> E | <u>M-7</u> |
| | T _____ R _____ | _____ |
| 2. Property Controlling in Section | S _____ T _____ R _____ | _____ |
| | S _____ T _____ R _____ | _____ |
| 3. Miscellaneous Property in Sec. | S _____ T _____ R _____ | _____ |
| | S _____ T _____ R _____ | _____ |

RECEIVED FOR RECORD
 LIBER NO. _____ PAGE NO. 73
 FILE NO. Dayton
 96 DEC 10 PM 4:49
 JUSCOLA COUNTY
 REGISTER OF DEEDS

Register of Deeds Stamp & File Number

4. Lot No. _____, Recorded Plat _____
 5. Private Claims _____

	A	B	C	D	E	F	G	H	I	J	K	L	M
2	6	5	4	3	2	1							
3													
4	7	8	9	10	11	12							
5													
6	18	17	16	15	14	13							
7	●												
8	19	20	21	22	23	24							
9													
10	30	29	28	27	26	25							
11													
12	31	32	33	34	35	36							
13													

I, Kenneth D. Dunton, in a field survey on April 21, 19 96, do hereby certify that under requirements of P.A. 74, Michigan P.A. of 1970, the corner points mentioned in lines 1 and 2 above were in conformance with regulations and rules therefore as required in the current manual of survey instructions of the United States Department of the Interior, Bureau of Land Management or by a decree of a Court of Law and/or that the corner points mentioned in lines 3, 4 and 5 above were in conformance with the rules of the Michigan Board of Land Surveyors or by a Decree of a Court of Law; established, re-established, monumented, re-monumented, recovered, found as expressed below:

NOTE: Not more than 4 corners, all in the same town and range, may be recorded on this certificate.

A. Description of original monument and accessories and/or subsequent restoration:

G.L.O. 1834	April 25, 1892
Harvey Parke, D.S.	G. B. Felton, County Surveyor
Set post corner Sections 13 & 24	Sec. 13 T11N-R9E
Beech 12 N16W35	From B.T.'s in 1875
Hemlock 30 S47W21	Sugar 4 N11E 175
Corner M-7, T11N-R9E	W. Birch 5 S13W 450

Note: Section A continued on back of form.

B. Description of corner evidence found and/or method applied in restoring or reestablishing corner:

Found 1/2" rod in 3/4" pipe. Accepted pipe & rod as the best evidence of the original corner.


C. Description of monument for corner and accessories established to perpetuate locating the position of the corner:

Set standard monument stamped M-7, T11N-R9E.
 S48°W 46.08' fnd. spike & #11192 tag in NW face p. pole.
 N14°W 101.35' set remon. tag & spike in E. face pin cherry V clump.
 N38°E 73.29' fnd. spike & #11192 tag in SE face p. pole.
 S48°E 32.68' set 1/2" x 18" rod & cap #23503 in road shoulder.

Note: This corner is common to M-7, T11N-R9E.

Signed by [Signature]
 Surveyor's Michigan License No. 23503

Date 10-30-96

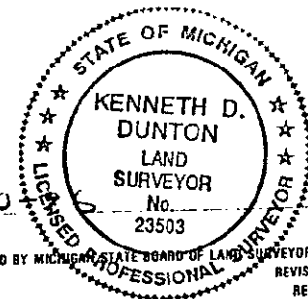

APPROVED
10-30-96

FORM APPROVED BY MICHIGAN STATE BOARD OF LAND SURVEYORS, JAN. 26, 1971
 REVISED MAY 14, 1975
 REVISED JAN., 1983

MEMO
 MAY 2 9 1997
 COMM.

29-

