

1996 REMONUMENTATION PROGRAM  
**LAND CORNER RECORDATION CERTIFICATE**  
 Filing Requirement of Act 74, Mich. P.A. 1970

For corners in Dayton Township

<u>Tuscola</u> <small>(County)</small>	Located In:	Corner Code #/
1. Public Land Survey	T <u>11N</u> R <u>10E</u>	<u>A-8</u>
	T <u>11N</u> R <u>8E</u>	<u>M-8</u>
2. Property Controlling in Section	S _____ T _____ R _____	_____
3. Miscellaneous Property in Sec.	S _____ T _____ R _____	_____
4. Lot No. _____, Recorded Plat _____		
5. Private Claims _____		

RECEIVED FOR RECORD  
 LIBER NO. \_\_\_\_\_ PAGE NO. 72  
 FILE NO. Dayton  
 96 DEC 10 PM 4:49  
 TUSCOLA COUNTY  
 REGISTER OF DEEDS

Register of Deeds Stamp & File Number

I, Kenneth D. Duntop in a field survey on April 21, 19 96, do hereby certify that under requirements of P.A. 74, Michigan P.A. of 1970, the corner points mentioned in lines 1 and 2 above were in conformance with regulations and rules therefore as required in the current manual of survey instructions of the United States Department of the Interior, Bureau of Land Management or by a decree of a Court of Law and/or that the corner points mentioned in lines 3, 4 and 5 above were in conformance with the rules of the Michigan Board of Land Surveyors or by a Decree of a Court of Law, established, re-established, monumented, re-monumented, recovered, found as expressed below:

**NOTE: Not more than 4 corners, all in the same town and range, may be recorded on this certificate.**

A	B	C	D	E	F	G	H	I	J	K	L	M
2	6	5	4	3	2	1						
3												
4	7	8	9	10	11	12						
5												
6	18	17	16	15	14	13						
7												
8	19	20	21	22	23	24						
9												
10	30	29	28	27	26	25						
11												
12	31	32	33	34	35	36						
13												

A. Description of original monument and accessories and/or subsequent restoration:

G.L.O. 1834	June 22, 1979
Harvey Parke, D.S.	L.C.R.C. form filed by James L. Quist, R.L.S. #25868 on
Set Quarter Section Post	Page 42, T11N-R10E.
Hemlock 9 S35W 21 1/2	Set 1/2" re-rod #11192 by single proportionate meas. between
W. Ash 6 N 32 1/2 W 23	NW & SW cor. Sec. 19, occupational lines match.
Corner M-8, T11N-R9E	S50°W 35.38' RLS #11192 tag 6" Oak
	S45°E 40.25' RLS #11192 tag 24" Maple
	N30°E 86.17' center 2" Maple
	West 4' + centerline gravel road N-S

B. Description of corner evidence found and/or method applied in restoring or reestablishing corner:

Found 1/2" rod & cap #25868, 5' + W. of N-S gravel centerline (iron is 0.25 W. & 0.11 S. of single proportion position). Held position of iron found as the best evidence of the original corner.

C. Description of monument for corner and accessories established to perpetuate localizing the position of the corner:


Set standard monument stamped M-8, T11N-R9E.  
 S46°W 23.10' set remon. tag & spike in SE root of twin 15" oaks.  
 S49°W 35.73' chiseled notch atop W. end of 40' of 30" CSP.  
 S47°E 30.83' chiseled notch atop E. end of 40' of 30" CSP.  
 S45°E 40.28' fnd. #11192 tag & spike in SW face 22' maple.

Note: This corner is common with M-8, T11N-R9E.

Signed by [Signature]  
 Surveyor's Michigan License No. 23503

Date 10-30-96

APPROVED  
10-30-96  
[Signature]

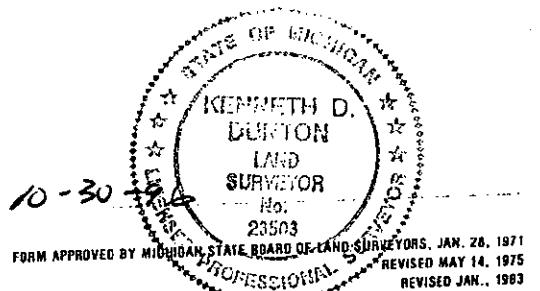

MAY 2 1997

COMMUNITY



T11N-R9E

Section 24

T11N-R10E

Section 19

