

1996 REMONUMENTATION PROGRAM
LAND CORNER RECORDATION CERTIFICATE
 Filing Requirement of Act 74, Mich. P.A. 1970

For corners in Dayton Township

<u>Tuscola</u> (County)	Located in:	Corner Code #
1. Public Land Survey	T11N R10E	<u>A-9</u> ✓
	T R	
	T11N R9E	<u>M-9</u>
	T R	
2. Property Controlling in Section	S T R	
	S T R	
3. Miscellaneous Property in Sec.	S T R	
	S T R	

RECEIVED FOR RECORD
 LIBER NO. _____ PAGE NO. 71
 FILE NO. Dayton
 96 DEC 10 PM 4:49
 TUSCOLA COUNTY
 REGISTER OF DEEDS

Register of Deeds Stamp & File Number

4. Lot No. _____, Recorded Plat _____
 5. Private Claims _____

I, Kenneth D. Dunton in a field survey on Apr. 21, 1996 do hereby state that under requirements of P.A. 74, Michigan P.A. of 1970, the corner points mentioned in lines 1 and 2 above were in conformance with regulations and rules therefore as required in the current manual of survey instructions of the United States Department of the Interior, Bureau of Land Management or by a decree of a Court of Law and /or that the corner points mentioned in lines 3, 4 and 5 above were in conformance with the rules of the Michigan Board of Land Surveyors or by a Decree of a Court of Law; established, re-established, monumented, recovered, found as expressed below:

A	B	C	D	E	F	G	H	I	J	K	L	M
1												
2	6		5		4		3		2		1	
3												
4	7		8		9		10		11		12	
5												
6	18		17		16		15		14		13	
7												
8	19		20		21		22		23		24	
9												
10	30		29		28		27		26		25	
11												
12	31		32		33		34		35		36	
13												

NOTE: Not more than 2 corners, all in the same town and range, may be recorded on this certificate.

A. Description of original monument and accessories and/or subsequent restoration:

G.L.O. 1834	April 10, 1891
Harvey Parke, D.S.	G. B. Felton, County Surveyor
Set Post Cor. Sections 24 & 25	Sec. 30, T11N-R10E
Hemlock 28 S69W 28	Set from B.T.'s in 1873 by self
Hemlock 9 N13W	Long blue stone & plow point at corner
Corner M-9, T11N-R9E	Tamarack 3 N24 3/4E 118

Note: Section A continued on back of form.

B. Description of corner evidence found and/or method applied in restoring or reestablishing corner:

Found railroad spike with "+" chiseled atop. Held as the best evidence of the original corner.


C. Description of monument for corner and accessories established to perpetuate locating the position of the corner:

Set standard monument stamped M-9, T11N-R9E.
 Set monument box over monument.
 N36°E 30.61' set 1/2" x 18" re-rod & cap #23503 in road shoulder
 South 32.77' fnd. 1/2" rod & cap #24588 2.7' + E. of town line.
 S45°W 70.79' fnd. #11192 tag & spike in SE face power pole.
 N51°W 88.03' set remon. tag & spike in SW face 12" spruce.

Note: This corner is common with M-9, T11N-R9E.

Signed by [Signature]
 Surveyor's Michigan License No. 23503

Date 10-30-96

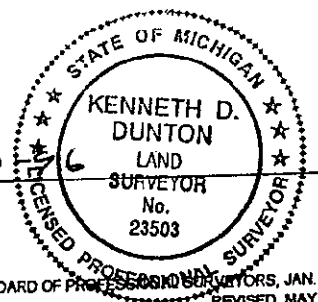

APPROVED
10-30-96
[Signature]

FORM APPROVED BY MICHIGAN STATE BOARD OF PROFESSIONAL SURVEYORS, JAN. 28, 1971
 REVISED MAY 14, 1975
 REVISED JAN., 1983
 REVISED OCT., 1995

MAY 20 1997

Aug. 19, 1893

G. B. Felton, County Surveyor

Sec. 25, T11N-R9E

Previously set

Pine 32 S 76 1/2 W 90

Long blue stone & plow point at cor.

June 22, 1979

L.C.R.C. form filed by James L. Quist, RLS #25868 on Page 42, T11N-R10E

Fnd. R.R. spike under new asphalt. Held R.R. spike.

S45°W 70.83' RLS #11192 tag p.p.

S35°W 25.57' E. edge E. leg dir. sign post.

N35°W 88.00' center of 2" maple.

June 25, 1979

Survey by James L. Quist, RLS #25868, L-499, P-644.

Same evidence and accessories as L.C.R.C. Page 42, T11N-R10E

