

1996 REMONUMENTATION PROGRAM  
**LAND CORNER RECORDATION CERTIFICATE**  
 Filing Requirement of Act 74, Mich. P.A. 1970

For corners in Dayton Township

Tuscola Located in: Corner Code #  
 (County)

1. Public Land Survey T11N R10E A-10  
 T R  
 T11N R9E M-10  
 T R  
 2. Property Controlling S T R  
 in Section S T R  
 3. Miscellaneous S T R  
 Property in Sec. S T R

RECEIVED FOR RECORD  
 LIBER NO. \_\_\_\_\_ PAGE NO. 70  
 FILE NO. Dayton  
 96 DEC 10 PM 4:49  
 TUSCOLA COUNTY  
 REGISTER OF DEEDS  
 Register of Deeds Stamp & File Number

4. Lot No. \_\_\_\_\_, Recorded Plat \_\_\_\_\_  
 5. Private Claims \_\_\_\_\_

I, Kenneth D. Dunton in a field survey on Apr. 21, 1996 do hereby state that under requirements of P.A. 74, Michigan P.A. of 1970, the corner points mentioned in lines 1 and 2 above were in conformance with regulations and rules therefore as required in the current manual of survey instructions of the United States Department of the Interior, Bureau of Land Management or by a decree of a Court of Law and/or that the corner points mentioned in lines 3, 4 and 5 above were in conformance with the rules of the Michigan Board of Land Surveyors or by a Decree of a Court of Law; established, re-established, monumented, recovered, found as expressed below:

	A	B	C	D	E	F	G	H	I	J	K	L	M
1													
2	6		5			4		3		2		1	
3													
4	7		8			9		10		11		12	
5													
6	10		17			16		15		14		13	
7													
8	19		20			21		22		23		24	
9													
10	30		29			28		27		26		25	
11													
12	31		32			33		34		35		36	
13													

NOTE: Not more than 2 corners, all in the same town and range, may be recorded on this certificate.

A. Description of original monument and accessories and/or subsequent restoration:

G.L.O. 1834	April 10, 1891
Harvey Parke, D.S.	G. B. Felton, County Surveyor
Set Quarter Section Post T11N, R9E	Survey of Sec. 30, T11N-R10E
Beech 10 S60W 32	Set from measurements
Beech 7 N27W 28	Pine 36 S69W 175
Corner M-10, T11N-R9E	Cedar post & crockery at corner

Note: Section A continued on back of form.

B. Description of corner evidence found and/or method applied in restoring or reestablishing corner:

Found 1/2" rod at SW corner of 12" wood post in conc. Held as best evidence of the original corner.


C. Description of monument for corner and accessories established to perpetuate locating the position of the corner:

Set standard monument stamped M-10, T11N-R9E and placed carsonite post by monument.  
 N25°W 5.02' fnd. spike & tag #37276 in NE face 12" pin cherry.  
 East 10.98' fnd. P.K. tag #37276 in S. face 10" post.  
 S15 °W 49.63' fnd. spike & tag #37276 in W. face 18" poplar.  
 S65°W 16.69' fnd. spike & tag #37276 in NW face 19" cottonwood.  
 N45°E 0.8' fnd. spike & tag #11192 in SE face old cor. post (post loose).

Note: This corner is common with M-10, T11N-R9E.

Signed by [Signature]  
 Surveyor's Michigan License No. 23503

Date 10-30-96

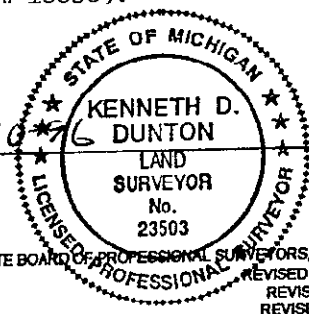

APPROVED  
10-30-96  
 [Signatures]

FORM APPROVED BY MICHIGAN STATE BOARD OF PROFESSIONAL SURVEYORS, JAN. 28, 1971  
 REVISED MAY 14, 1975  
 REVISED JAN., 1983  
 REVISED OCT., 1995

REASON  
 MAY 2 9 1997  
 COPIES

August 19, 1893  
 G. B. Felton, County Surveyor  
 Survey Section 25, T11N-R9E  
 Previously set from meas.  
 Pine 36 S69W 175

July 19, 1973  
 Survey by David T. Rowe, RLS #11192, L-434, P-791  
 Set rod w/cap  
 East 10.9' anchor post in conc.  
 S45°W 17.2' RLS #11192 tag in 12" nut tree  
 N45°W 19.6' RLS #11192 tag in 15" poplar

June, 1973 L.C.R.C. form filed by David T. Rowe, RLS #11192 on Page 26, T11N-R9E  
 Same object and accessories as shown on Liber 434, Page 791

May 9, 1975  
 Survey by James A. Beck, RLS #21559, L-452, P-595  
 Rod w/cap @ W. face cor. post  
 East 10.9' anchor post in conc.  
 S45°W 17.2' Rowe RLS tag in 12" nut tree  
 N45°W 19.6' Rowe RLS tag in 15" poplar

May 28, 1975  
 Survey by James A. Beck, RLS #21559, L-452, P-640, 641 & 642  
 No mention of evidence found or set or accessories.

June 12, 1986  
 Survey by Jack N. Owens, LLS #20709, L-564, P-10 & 11  
 Fnd. 5/8" re-rod  
 N11°W 70.49' E. face multi elm  
 N87°W 53.03' 2" maple  
 S31°31'W 39.84' W. face multi elm  
 N88°W 24.51' fence corner

March 22, 1994  
 Survey by Jonathan M. Field, I.L.S. #37276, L-663, P-428 & 429  
 Fnd. 1/2" rod  
 N25°W 4.85' set nail w/tag #37276 in NE face 10" cherry  
 East 11.05' set P.K. nail & tag #37276 in S. face fence post  
 S45°W 16.79' set nail w/tag #37276 in S. face 10" fence post  
 S10°W 49.81' set nail w/tag #37276 in W. face 14" poplar.

