MAY 0.5 1997	LAND COR	LAND CORNER RECORDATION CERTIFICATE							
COMMISSION For corners in DAYTON TWI	Filing Requirement of Act 74, Mich. P.A. 1970				8018 3018 3018		95 DE	STEEL NO.	RECEIV
TUSCOLA (County)	Located In:	Corner Code #			180 mg m m m m m m m m m m m m m m m m m m		C 26	ابج	# 0 #0
Public Land Survey	T_11N_R_10E TR T_//N_R9E	M-13			SQEED A		MII: 50	100 July 20	r record
3. Miscellaneous S	T R T R T R		Regist	er of D	eeds S	Stamp (& File I	Numbe	er
4. Lot No, Records 5. Private Claims	ed Plat		1	A B	C D	E F +	э н	IJĶ	i i M
			2	6	5	4	3	2	1
I. JONATHAN M. FIELD , in a field survey on JULY 14 19 94 do hereby certify that under requirements of P.A. 74, Michigan P.A. of 1970, the corner points mentioned in lines 1 and 2 above were in conformance with regulations and rules therefore as required in the current manual of survey instructions of the United States Department of the Interior, Bureau of Land Management or by a decree of a Court of Law and/or that the corner points mentioned in lines 3, 4 and 5 above were in conformance with the rules of the Michigan Board of Land Surveyors or by a Decree of a Court of Law; established, re-established, monumented, re-monumented, recovered, found as expressed below:			4 5	7	8	9	10	11	12
			e 6	18	17	16	15	14	13
			2 .	19	20	21	22	23	24
NOTE: Not more than 4 corner on this certificate.	rs, all in the same town	and range, may be recorded	10 11	30	29	28	27	26	25

- Description of original monument and accessories and/or subsequent restoration:
- 1834 GLO; PARKE, D.S.; SET POST; BEECH 24 N39E 27LKS., BEECH 9 N70W 30LKS.
- 1897 FELTON, C.S.; SURVEY OF SEC.31, T11N-R10E; PREV SET BY MILLS FROM B.T'S; OBJECT NOT STATED; SUGAR 10 N1 1/2E 45 1/2LKS., SUGAR 11 N35 1/2E 27 1/2LKS.
- 1974 ROWE ENG; ROWE, P.S.#11192; LCRC 28; SET 3/8" ROD ON FENCE LINE NORTH AND ON LINE BETWEEN SE COR. SEC.31, T11N-R10E & NW COR. SEC.5, T10N-R10E; S15W 30.93' RLS 11192 TAG IN 12" TREE, S10°W 84.94' RLS 11192 TAG IN 18" TREE, NORTH 10.25' C/L 30.5' GRAVEL ROAD
- Description of corner evidence found and/or method applied in restoring or reestablishing corner: 1994 ROWE ENG.; FIELD, P.S.#37276; FND. NO EVIDENCE OF MONUMENT AT CORNER

DID NOT ACCEPT METHOD OF ESTABLISHING CORNER BY ROWE IN 1974 RE-ESTABLISHED CORNER POSITION BY SINGLE PROPORTION BETWEEN CORNERS L-13, T11N-R9E AND B-13, T11N-R10E. NOTE THIS POSITION IS 3' N. OF THE CENTERLINE OF THE GRAVEL ROAD AS INDICATED BY THE 1974 WITNESS AND IS WITHIN 1' OF 5280' TO M-11 T11N-R11E AS NOW MONUMENTED AND IS ALSO WITHIN 0.1' OF LINE FROM K-13 THROUGH L-13 T11N-R9E

Description of monument for corner and accessories established to perpetuate locating the position of the corner: A-13 SET STANDARD REMON MONUMENT, CAP STAMPED "M 13 T11N R9E" IN MON. BOX

N68°W, 122.48' SET NAIL W/REMON TAG ABOVE FND P-K NAIL W/FLAG IN S. FACE P.POLE

84.81' SET NAIL W/REMON TAG ABOVE FND NAIL W/FLAG IN W. FACE 28" MAPLE NORTH.

42.64' SET 1/2" ROD S55°W,

S47°E, 37.94' SET 1/2" ROD

9.3' C/L ASPH. ROAD

This corner is common with M-13 TllN-R9E

NOTE: MONUMENT AND ACCESSORIES SET 9-2-94

Moder Signed by

Surveyor's Michigan License No. 37276

Date

31

33

35

MILAND C POLESSHE


OFBILH

NAHTANOL

M. FIELD **PROFESSIONAL** SURVEYOR

37278

APPROVED

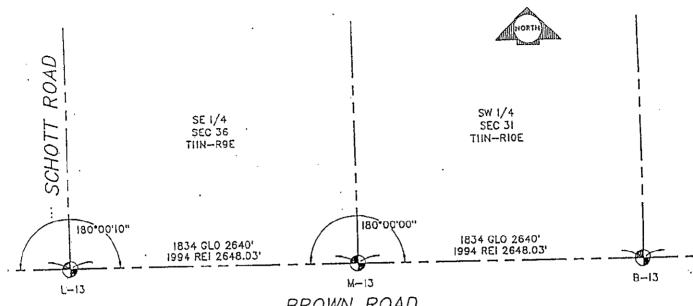

BROWN ROAD