

OCT 26 1994

COMMISSION

1994 REMONUMENTATION PROGRAM
LAND CORNER RECORDATION CERTIFICATE
Filing Requirement of Act 74, Mich. P.A. 1970

For corners in DAYTON TOWNSHIP

| TUSCOLA (County) | Located In: | Corner Code # |
|---------------------------------------|-------------------------|---------------|
| 1. Public Land Survey | T 11N. R 10E | B-13 |
| | T _____ R _____ | _____ |
| | T _____ R _____ | _____ |
| | T _____ R _____ | _____ |
| 2. Property Controlling in Section | S _____ T _____ R _____ | _____ |
| | S _____ T _____ R _____ | _____ |
| 3. Miscellaneous Property in Sec. | S _____ T _____ R _____ | _____ |
| | S _____ T _____ R _____ | _____ |

RECEIVED FOR RECORD
LIBER NO. _____ PAGE NO. _____
FILING NO. # 67
DAYTON TOWNSHIP
94 OCT -4 AM 10:32
VIRGINIA H. MELANEE
TUSCOLA COUNTY
REGISTER OF DEEDS

Register of Deeds Stamp & File Number

- 4. Lot No. _____, Recorded Plat _____
- 5. Private Claims _____

| | A | B | C | D | E | F | G | H | I | J | K | L | F |
|----|----|---|----|---|----|---|----|---|----|---|----|---|---|
| 2 | 6 | | 5 | | 4 | | 3 | | 2 | | 1 | | |
| 3 | | | | | | | | | | | | | |
| 4 | 7 | | 8 | | 9 | | 10 | | 11 | | 12 | | |
| 5 | | | | | | | | | | | | | |
| 6 | 18 | | 17 | | 16 | | 15 | | 14 | | 13 | | |
| 7 | | | | | | | | | | | | | |
| 8 | 19 | | 20 | | 21 | | 22 | | 23 | | 24 | | |
| 9 | | | | | | | | | | | | | |
| 10 | 30 | | 29 | | 28 | | 27 | | 26 | | 25 | | |
| 11 | | | | | | | | | | | | | |
| 12 | 31 | | 32 | | 33 | | 34 | | 35 | | 36 | | |
| 13 | | | | | | | | | | | | | |

I, Lionel Roy Emery, in a field survey on May 24, 1994, do hereby certify that under requirements of P.A. 74, Michigan P.A. of 1970, the corner points mentioned in lines 1 and 2 above were in conformance with regulations and rules therefore as required in the current manual of survey instructions of the United States Department of the Interior, Bureau of Land Management or by a decree of a Court of Law and/or that the corner points mentioned in lines 3, 4 and 5 above were in conformance with the rules of the Michigan Board of Land Surveyors or by a Decree of a Court of Law; established, re-established, monumented, re-monumented, recovered, found as expressed below:

NOTE: Not more than 4 corners, all in the same town and range, may be recorded on this certificate.

A. Description of original monument and accessories and/or subsequent restoration:

- 1834 (Gov't. Land Office Notes) Harvey Parke, D.S. -Set quarter Section post- Beech 15 S34W 20; Beech 15 S57E 10
- ** 1974 (Land Corner Recordation Certificate) David T. Rowe, P.S. 11192 -set "T" Iron by single proportionate Meas.- N65°E 118.14' RLS 11192 tag in PP; N15°E 132.84' SW Cor. new addition house #645; N45°W 160.18' SE Cor. House #619; S02°E 110.4' Center 30" Elm
- 1978 (Survey -Liber 489, pages 1148 and 1149) Arthur H. Leach, P.S. 7236 -Found "T" Iron- N50°E -117.75' to top ctr. tel. riser; N25°E -88.60' to fc. 4" fruit tree; South -13.21' to 3" " iron in South shoulder of Gravel Rd.
- 1978 (Land Corner Recordation Certificate) Arthur H. Leach, P.S. 7236 -Found "T" Iron by search- See over for continuation of Section "A."

B. Description of corner evidence found and/or method applied in restoring or reestablishing corner:

Found "T" Iron in previous Gravel road surface 18" below present Macadam surface. Iron to SW Corner of House #645 and to Power Pole checks Rowe's measurements Accepted found "T" Iron as marking original corner.

C. Description of monument for corner and accessories established to perpetuate locating the position of the corner:

Removed "T" Iron and replaced with Standard Tuscola County Concrete Monument w/2" Brass Cap stamped B13 T11N R10E. Placed iron "Monument Box" over Concrete Monument. N20°E, 128.17' -T.C. Remon. tag in West face of 16" Apple tree N25°E, 133.01' -SW Corner (@ concrete block) of House #645 N65°E, 117.63' -T.C. Remon. tag in SE face of power pole S40°W, 18.25' -set 5/8" diameter reinforcing rod


Signed by Lionel Roy Emery

Date October 4, 1994

Surveyor's Michigan License No. 24593

APPROVED
8-29-94

Handwritten initials and signatures

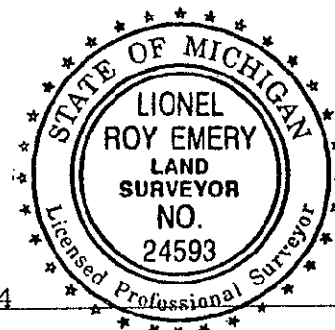

Accessories on Land Corner Recordation Certificate same as shown on above Survey by Arthur Leach
 1987 (Survey -for Paul Vaughan) Jack N. Owens, P.S. 20709 -FND. "T" iron- Accessories same as 1978 Land Corner Certificate by David T. Rowe.
 **1897 (County Surveyor's Record) G.B. Felton, Tuscola County Surveyor -set from Meas.-C.P. & Crockery corner. No accessories given

