COMMISSION

1994 REMONUMENTATION PROGRAM

LAND	CORNER	RECORDATION	CERTIFICATE

			LAND CORNER RECORDATION CERTIFICATE		
For corners in	DAYTON	TOWNSHIP	Filing Requirement of Act 74, Mich. P.A. 1970		

TUSCOLA Located In: Corner Code ## (County) 1. Public Land Survey T11N R10E C-13 T _____ R ____ T _____ R _ T _____ R ___ 2. Property Controlling ____ T ____ R _ in Section S ____ T ___ R _ Miscellaneous ___ T ___ R ____ Property in Sec.

Register of Deeds Stamp & File Number

i.	Lot No.	· · · · · · · · · · · · · · · · · · ·	, Recorded	Plat	

5. Private Claims _

t. Lionel Roy Emery, in a field survey on May 24 do hereby certify that under requirements of P.A. 74, Michigan P.A. of 1970, the corner points mentioned in lines 1 and 2 above were in conformance with regulations and rules therefore as required in the current manual of survey instructions of the United States Department of the Interior, Bureau of Land Management or by a decree of a Court of Law and/or that the corner points mentioned in lines 3, 4 and 5 above were in conformance with the rules of the Michigan Board of Land Surveyors or by a Decree of a Court of Law; established, re-established, monumented, re-monumented, recovered, found as expressed below:

NOTE: Not more than 4 corners, all in the same town and range, may be recorded on this certificate.

A. Description of original monument and accessories and/or subsequent restoration:

1834 (Government Land Office Notes)

Harvey Parke, D.S. -set post Cor Sections 31,32

Beech 22 N63E 49; Sugar 9 N57W 33

1974 (Land Corner Recordation Certificate) David T. Rowe, P.S. 11192 -1" Iron (does not say whether found/set) N45°W 47.58' RLS tag in 15" Maple; S10°E 25.28' RLS 11192 tag in W. face 24" Maple; S10°W 26.80' RLS tag in NW face 15" Maple; East 56.00 feet CL joint Conc. pave't

1978 (Survey -Liber 489, pages 1148 and 1149) Arthur H. Leach, P.S. 7236 -found 3/4" solid iron-N35°W-41.55' to 14" Maple; S30°E-25.45' to 12" Maple; S30°W-26.80' to 18" Maple; N40°E -37.88' to top ctr. tel. riser

1978 (Land Corner Recordation Certificate) Arthur H. Leach, P.S. 7236 -shows marker and See over for continuation of Section "A."

B. Description of corner evidence found and/or method applied in restoring or reestablishing corner:

Found 3/4" diameter 24" long smooth rod and remaining witnesses

Accepted found rod as marking original corner.

C. Description of monument for corner and accessories established to perpetuate locating the position of the corner: Removed iron rod and replaced with Standard Tuscola County Standard Concrete Monument w/2" Brass Cap stamped C13 T11N R10E. Placed iron "Monument Box" over Concrete Monument. S05°W, $2\overline{2}.62$ ' -set $\frac{1}{2}$ " diameter reinforcing rod

S40°W, 66.16' -T.C. Remon. tag over found P.K. nail in SE face of power pole

S65°W, 117.84' -T.C. Remon. tag in North face of 36" Maple

N35°W, 56.30' -T.C. Remon. tag over found nail in SW face of 24" Maple

LIONEL ROY EMERY LAND SURVEYOR NO. 24593 Profession


Date October 4,


Surveyor's Michigan License No. 24593

FORM APPROVED BY MICHIGAN STATE BOARD OF LAND SURVEYORS, JAN. 28, 1971 REVISED MAY 14, 1975

accessories same as above Survey.

- 1988 (Survey for Paul Vaughan) B.D. Ferguson, P.S. 26454 -3/4" solid rod (does not say whether found or set) N50°W-34.55'-Top center MBT Box; S75°W-86.05'-NE cor. conc. R/W Marker; EAST-55.00'-Centerline of M-24 Pavement
- 1993 (Survey for Dwight Bell) Jonathan M. Field, P.S. 37276 -Fnd. 1" Rod- S45°E, 29.20' S. edge of stop sign post; S50°W, 66.10' Fnd. P-K nail in SE face P.pole; N40°W, 56.10' Fnd. P-K nail in SW face 16" Maple; N35°W, 40.20' Center of telephone riser; East, 56.49' Centerling of M-24
- **1897 (County Surveyor's Record) G.B. Felton, Tuscola County Surveyor -set from Meas.- perpetuated by Hickory 4 in. diameter, N71 3/4E 68% links, C.P. Stone & Crockery cor.

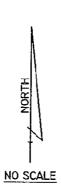

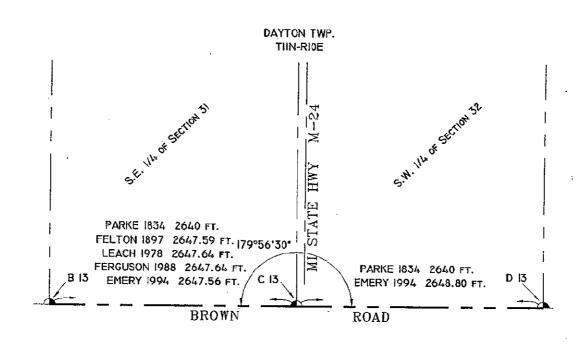

RICH TOWNSHIP LAPEER COUNTY