

OCT 20 1994

COMMISSION

1994 REMONUMENTATION PROGRAM
LAND CORNER RECORDATION CERTIFICATE
Filing Requirement of Act 74, Mich. P.A. 1970

For corners in DAYTON TOWNSHIP
TUSCOLA

(County)	Located In:	Corner Code #
1. Public Land Survey	T <u>11N</u> R <u>10E</u>	<u>D-13</u>
	T _____ R _____	_____
	T _____ R _____	_____
	T _____ R _____	_____
2. Property Controlling in Section	S _____ T _____ R _____	_____
	S _____ T _____ R _____	_____
3. Miscellaneous Property in Sec.	S _____ T _____ R _____	_____
	S _____ T _____ R _____	_____
4. Lot No. _____, Recorded Plat _____		
5. Private Claims _____		

RECEIVED FOR RECORDING
LIBER NO. _____ PAGE NO. _____
FILING NO. # 605
DAYTON TWP.
94 OCT -4 AM 10:32

Register of Deeds Stamp & File Number

	A	B	C	D	E	F	G	H	I	J	K	L	M
2	6	5	4	3	2	1							
3													
4	7	8	9	10	11	12							
5													
6	18	17	16	15	14	13							
7													
8	19	20	21	22	23	24							
9													
10	30	29	28	27	26	25							
11													
12	31	32	33	34	35	36							
13													

I, Lionel Roy Emery, in a field survey on May 23, 1994, do hereby certify that under requirements of P.A. 74, Michigan P.A. of 1970, the corner points mentioned in lines 1 and 2 above were in conformance with regulations and rules therefore as required in the current manual of survey instructions of the United States Department of the Interior, Bureau of Land Management or by a decree of a Court of Law and/or that the corner points mentioned in lines 3, 4 and 5 above were in conformance with the rules of the Michigan Board of Land Surveyors or by a Decree of a Court of Law; established, re-established, monumented, re-monumented, recovered, found as expressed below:

NOTE: Not more than 4 corners, all in the same town and range, may be recorded on this certificate.

A. Description of original monument and accessories and/or subsequent restoration:

1834 (Gov't. Land Office Notes) Harvey Parke, D.S. -set quarter Section post- Beech 9 N56W 14½
Beech 9 N78E 41


No evidence found of original corner and occupation consists of field (crop) division only

B. Description of corner evidence found and/or method applied in restoring or reestablishing corner:

No evidence found, reestablished by single proportion measurement.

C. Description of monument for corner and accessories established to perpetuate locating the position of the corner:

Set Standard Tuscola County Concrete Monument w/ 2" Brass Cap stamped D13 T11N R10E
N80 E, 125.48' -T.C. Remon. tag in South face of 16" Hickory
S50 E, 26.68' -set 5/8" diameter reinforcing rod
S30 W, 14.98' -set 5/8" diameter reinforcing rod
N10 W, 28.96' -T.C. Remon. tag in East face of 12" Wood post

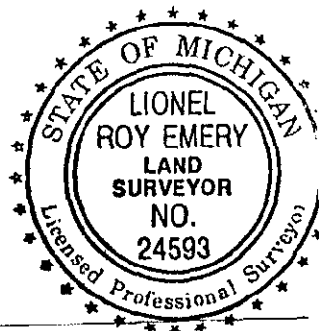

Signed by Lionel Roy Emery

Date October 4, 1994

Surveyor's Michigan License No. 24593

APPROVED
E-29-94



NO SCALE

