OCT 2 0 1994

1994 REMONUMENTATION PROGRAM

COMMUNICATION			SUCN	LAND CORNER RECORDATION CERTIFICATE									
For c	TUSC	OLA	TOWNSHIP	Filing Require	ement of Act 74, Mich. F	P.A. 1970		REGER TUSCE		2 PA 7 PA			
1. Public Land Survey		T 11N. R 10E T R T R					GEED TO SEE	<u> </u>	70N 7W	PAGE!	FOR REC		
ir	roperty Co n Section fiscellaned	_	S T _ S T _ S T _	R R		Regis	ter of I	ပာ ် Deeds	ti n	0 C	ි e Nu	٠.,	•
Ρ	roperty in	Sec.	S T _	R			•	···					<u></u>
							A B	C D	E F	GН	1 .	JΚ	L N
5. P	rivate Clai	ms				<u> </u>		TT	T	TT	T	П	T
							3 6-	- <del> </del> 5-	†-1°	<b>†</b> ₁³ -		2	-1-
								1	1	1			1
r Til	onol Poi	u Emoru	in a field suc-	ou oo May 25			5 7-		+-9-	10-		1	-12 
do hei	reby certify	that under rec	uirements of P.A	. 74, Michigan P.A.	of 1970, the corner points ment	tioned			<del>  -  </del>	111	$\top$		_
				~	d rules therefore as required	in the	6   1'8		16- I	-15- I		14	13
				-	lment of the Interior, Bureau of Ir points mentioned in lines 3, 4	Lanu	<b>7</b>	1-1-	<del>                                     </del>	++		1	1
-	_	•			of Land Surveyors or by a Decre	ee of a	8 19-		21-	22·	-	23 <del></del>	—24 I
			e-established, n	nonumented, re-n	nonumented, recovered, four	nd as	°	11-	1	+-	-		_
-	ssed below						<sup>0</sup>  —зо	29	28	27-		<u>26</u>	-25
NOTE	E: Not more than 4 corners, all in the same town and range, may be recorded						<u> </u>	11-	1-1-	++	_		+
	on this	certificate.					2 -31-	32-	- 33-	34-	+	/5	3 <del>6</del>
Δ Ω	\aecrintion	of orininal s	monument and	annassarias and	d/or subsequent restoration		3		<del>- •</del>			<del> </del>	
183	4 (Gov'	t. Land ( 8 N88E 3	)ffice Note 30	s) Harvey Pa	arke, D.Sset qua	rter Sect						7½W	16
197	1 (Surve	ev -Liber	1 of Surv	eys, page 30 .P.: S40°E 3	01) Bernard Henders 33.5' Nail & Cap 24	on, P.S. " Map.	#1604	43 <b>-</b> s	et ½	'iro	n-		
197	2 (Land	Corner F	Recordation	Certificate	e) David T. Rowe, P	.S. #1119	2 -Fi	nd. ½	" re	-rod-	- <b>S</b> 4	15°E	, 32.
	nail 8	& cap in	36" Maple;	North 33.00	"T" iron; South	יי 100.33.	" ir	on; E	ast 2	287.5	<u>+</u> د	C.L	. Of
	Drive	way for h	nouse #1661	•									_
197	7 (Surve	ey -Liber	478, page	80   and   40   an	81) James A. Beck, th 33.00' T-iron; S	P.S. #215 Outh 33.0	59 –∃ יחייתייתי	Fnd. -iron	½" R	≥-ro	1- S	;45°.	Е
107	32.02 7 (Surve	naii a av Lihar	cap in soe	$\approx$ 1298 and	1299) James A. Beck	re-reco	rded	abov	e Su	rvev	(Se	e o	ver)
B. D	lescription	of corner e	vidence found	and/or method a	applied in restoring or reest	tablishing co	rner:		_ 20.	1	· · · · ·	-	1
					midpoint of South S			f Sec	tion	33			
		p #23510		L L	•								
				s marking of	riginal corner								

C. Description of monument for corner and accessories established to perpetuate locating the position of the corner:

Removed 2" reinforcing rod and replaced with Standard Tuscola County Concrete Monument W/ 2" Brass Cap stamped F13 T11N R10E

N25°E, 20.71'-T.C. Remon. tag over found nail in East face of 6" Elm


N60°E, 38.62'-T.C. Remon. tag over found nail in North face of 8" Ash

South, 23.56'-set ½"x18" reinforcing rod NO4°W, 33.12'-found "T" iron

SUBVEYORS TAN 28 REVISED MAY 14, 1975 REVISED JAN., 1983

ROY EMERY LAND SURVEYOR NO. 24593



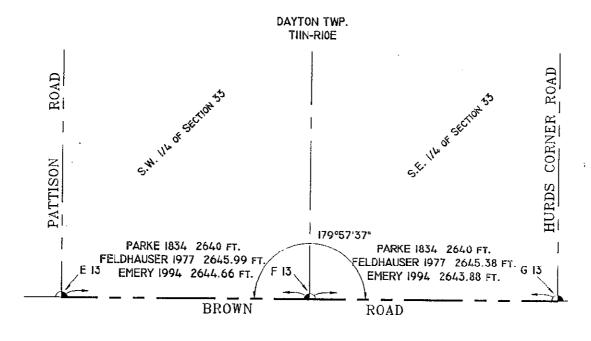

RICH TOWNSHIP