

SURVEY &  
MONUMENTATION

OCT 20 1994

COMMISSION

1994 REMONUMENTATION PROGRAM  
LAND CORNER RECORDATION CERTIFICATE  
Filing Requirement of Act 74, Mich. P.A. 1970

For corners in DAYTON TOWNSHIP  
TUSCOLA  
(County)

	Located In:	Corner Code #
1. Public Land Survey	T <u>11N</u> R <u>10E</u>	<u>G-13</u>
	T _____ R _____	_____
	T _____ R _____	_____
	T _____ R _____	_____
2. Property Controlling in Section	S _____ T _____ R _____	_____
	S _____ T _____ R _____	_____
3. Miscellaneous Property in Sec.	S _____ T _____ R _____	_____
	S _____ T _____ R _____	_____
4. Lot No. _____, Recorded Plat _____		
5. Private Claims _____		

RECEIVED FOR RECORD  
LIBER NO. \_\_\_\_\_ PAGE NO. \_\_\_\_\_  
FILING NO. # 62  
DAYTON TWP.  
94 OCT -4 AM 10:33  
VIRGINIA H. HEDGECOCK  
TUSCOLA COUNTY  
REGISTER OF DEEDS

Register of Deeds Stamp & File Number


I, Lionel Roy Emery, in a field survey on May 25, 19 94, do hereby certify that under requirements of P.A. 74, Michigan P.A. of 1970, the corner points mentioned in lines 1 and 2 above were in conformance with regulations and rules therefore as required in the current manual of survey instructions of the United States Department of the Interior, Bureau of Land Management or by a decree of a Court of Law and/or that the corner points mentioned in lines 3, 4 and 5 above were in conformance with the rules of the Michigan Board of Land Surveyors or by a Decree of a Court of Law, established, re-established, monumented, re-monumented, recovered, found as expressed below:

A	B	C	D	E	F	G	H	I	J	K	L
2	6	5	4	3	2	1					
3											
4	7	8	9	10	11	12					
5											
6	18	17	16	15	14	13					
7											
8	19	20	21	22	23	24					
9											
10	30	29	28	27	26	25					
11											
12	31	32	33	34	35	36					
13											

NOTE: Not more than 4 corners, all in the same town and range, may be recorded on this certificate.

- A. Description of original monument and accessories and/or subsequent restoration:  
1834 (Gov't. Land Office Notes) Harvey Parke, D.S. -set post cor, Sections 33,34- Beech 7 N11W Beech 9 N71E 33 1/2  
1971 (Survey -Liber 1 of Surveys, page 301) Bernard Henderson, P.S.#16043 -found iron- N40°W 44' Road Sign; N15°E 79.27' Nail & Cap 30" Ash; N50°E 44.8' Nail & Cap in 36" Stump  
1972 (Land Corner Recordation Certificate) David T. Rowe, P.S. #11192 -fnd 1/2" re-rod- N45°W 42.6' Nail & disc in guy pole; N35°W 44.65' Rd. sign post; N15°E 79.28' nail & disc in 36" Ash  
1972 (Land Corner Recordation Certificate) Harold N. Elrich, P.S. #18986 -Found 1/2" Iron-accessories same as shown on 1971 Survey by Bernard Henderson (listed above)  
1974 (Survey -Liber 444, page 195) Robert G. Kay, P.S. #14096 -no corner data shown on survey-  
1977 (Survey -Liber 478, page s 480 and 481) James A. Beck, P.S. #21559 -Fnd. 1/2" Re-Rod (See over)
- B. Description of corner evidence found and/or method applied in restoring or reestablishing corner:  
Found 5/8" x 30" reinforcing rod (top deteriorated to 1/2" dia.)  
accepted found iron and remaining accessories as marking original corner

- C. Description of monument for corner and accessories established to perpetuate locating the position of the corner:  
Removed iron rod and replaced with Standard Tuscola County Concrete Monument w/ 2" Brass Cap stamped G13 T11N R10E  
N15°E, 79.11' -T.C. Remon, tag in West face of 36" Ash  
S55°E, 65.53' -T.C. Remon. tag in N.E. face of 16" Chinese Elm  
S85°W, 88.56' -T.C. Remon. tag in South face of 4" Elm  
N45°W, 42.63' -T.C. Remon. tag in S.W. face of Utility pole stub

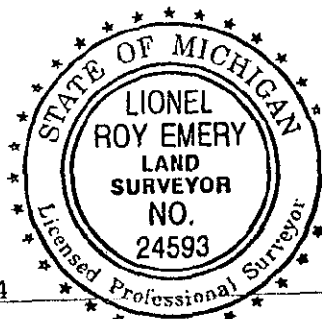

Signed by Lionel Roy Emery Date October 4, 1994

Surveyor's Michigan License No. 24593

APPROVED  
8-29-94  
*[Signature]*

- N35°W 44.65' Rd. sign Post; N15°E 79.25' RLS. 11192 tag in 30" Ash; N50°E 44.78' nail & disc in 36" Elm stump
- 1977 (Survey -Liber 603, pages 1298 and 1299) James A. Beck, P.S. #21559 -same accessories as ab Survey re-recorded
- 1977 (Survey -for Lakehill Development Co.) Feldhauser Associates survey #6553 (No Signature) Fnd ½" rod---no further data
- 1989 (Survey for Farm Credit Services --Lapeer County Survey) Kenneth D. Dunton, P.S. #23503 No accessories given
- 1990 (Land Corner Recordation Certificate) Kenneth D. Dunton, P.S.#23503 -found iron- N50°W, 42. nail in tele . pole stub; N10°E 79.0' nail in 36" Ash; S70°E 65.6' nail in 10" Elm; N45°E 44.6' Road sign post

