

SURVEY &  
REMONUMENTATION

OCT 20 1994

COMMISSION

1994 REMONUMENTATION PROGRAM  
LAND CORNER RECORDATION CERTIFICATE  
Filing Requirement of Act 74, Mich. P.A. 1970

RECEIVED FOR RECORD  
LIBER NO. \_\_\_\_\_ PAGE NO. \_\_\_\_\_  
FILING NO. # 60  
DAYTON TOWNSHIP  
9th OCT - 4 AM 10:33  
VIRGINIA H. HILLIARD  
TUSCOLA COUNTY  
REGISTER OF DEEDS

For corners in DAYTON TOWNSHIP  
TUSCOLA  
(County)

	Located In:	Corner Code #
1. Public Land Survey	T 11N R 10E	I-13
	T _____ R _____	_____
	T _____ R _____	_____
	T _____ R _____	_____
2. Property Controlling in Section	S _____ T _____ R _____	_____
	S _____ T _____ R _____	_____
3. Miscellaneous Property in Sec.	S _____ T _____ R _____	_____
	S _____ T _____ R _____	_____

Register of Deeds Stamp & File Number

4. Lot No. \_\_\_\_\_, Recorded Plat \_\_\_\_\_  
5. Private Claims \_\_\_\_\_

	A	B	C	D	E	F	G	H	I	J	K	L	M
2	6		5		4		3		2		1		
3													
4	7		8		9		10		11		12		
5													
6	18		17		16		15		14		13		
7													
8	19		20		21		22		23		24		
9													
10	30		29		28		27		26		25		
11													
12	31		32		33		34		35		36		
13													

I, Lionel Roy Emery, in a field survey on May 26, 19 94, do hereby certify that under requirements of P.A. 74, Michigan P.A. of 1970, the corner points mentioned in lines 1 and 2 above were in conformance with regulations and rules therefore as required in the current manual of survey instructions of the United States Department of the Interior, Bureau of Land Management or by a decree of a Court of Law and/or that the corner points mentioned in lines 3, 4 and 5 above were in conformance with the rules of the Michigan Board of Land Surveyors or by a Decree of a Court of Law; established, re-established, monumented, re-monumented, recovered, found as expressed below:

**NOTE: Not more than 4 corners, all in the same town and range, may be recorded on this certificate.**

A. Description of original monument and accessories and/or subsequent restoration:

- 1834 (Gov't. Land Office Notes) Harvey Parke D.S. -set post Cor. Sections 34,35- B. Ash 11 N67½E 7; Hemlock 6 N42W 13
- 1971 (Survey-Liber 1 of surveys, page 304) Harold N. Elrich P.S. #18986 -set ½" dia. iron stake-S45°W 21.21' nail & cap in 12" Map.; N5°E 10.22' Nail & Cap 10" Willow; N45°E 13.27' Nail & Cap in 24" Pop.
- 1993 (Survey for Roger and Carolyn Fisher) Earl E. Gravlin, P.S. #23510 -Found ½" Re-rod- S45°W 21.50' nail N. side 20" Ash; N50°W 21.50' nail S. side 10" Ash; N45°E 11.65' nail in S. side 8" Oak
- 1993 (Survey for Roy Rich) Earl E. Gravlin, P.S. #23510 accessories same as previous survey


B. Description of corner evidence found and/or method applied in restoring or reestablishing corner:

Found ½" dia. iron stake and accessories

Accepted iron stake as marking original corner

C. Description of monument for corner and accessories established to perpetuate locating the position of the corner:

- Removed ½" iron stake and replaced with Standard Tuscola County Concrete Monument w/2" Brass Cap stamped I13 T11N R10E
- North, 1.0'-Fiberglass "Survey Marker" witness post
- N60°E, 11.70'-T.C. Remon. tag over fnd. nail in S.E. face of 8" Oak
- N80°E, 23.83'-T.C. Remon. tag in S.E. face of 8" Elm
- S45°W, 21.50'-T.C. Remon. tag over found nail in N.W. face of 18" Ash
- N60°W, 21.54'-T.C. Remon. tag over found nail in S.W. face of 10" Ash

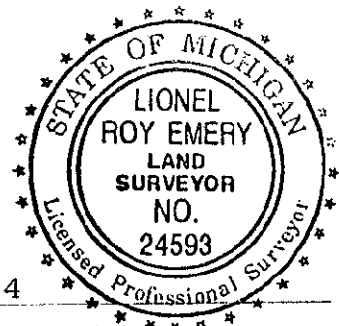

Signed by Lionel Roy Emery

Date October 4, 1994

Surveyor's Michigan License No. 24593

APPROVED  
8-8-94



NO SCALE

