

OCT 20 1994

COMMISSION

1994 REMONUMENTATION PROGRAM
LAND CORNER RECORDATION CERTIFICATE
Filing Requirement of Act 74, Mich. P.A. 1970

For corners in DAYTON TOWNSHIP

RECEIVED FOR RECORD
LIBER NO. _____ PAGE NO. _____
FILING NO. #59
DAYTON TWP.
91 OCT -4 AM 10:33
VIRGINIA H. HOLLAND
TUSCOLA COUNTY
REGISTER OF DEEDS

Register of Deeds Stamp & File Number

TUSCOLA (County)	Located In:	Corner Code -##
1. Public Land Survey	T 11N. R 10E	J-13
	T _____ R _____	_____
	T _____ R _____	_____
	T _____ R _____	_____
2. Property Controlling in Section	S _____ T _____ R _____	_____
	S _____ T _____ R _____	_____
3. Miscellaneous Property in Sec.	S _____ T _____ R _____	_____
	S _____ T _____ R _____	_____

- 4. Lot No. _____, Recorded Plat _____
- 5. Private Claims _____

I, Lionel Roy Emery in a field survey on May 26, 1994, do hereby certify that under requirements of P.A. 74, Michigan P.A. of 1970, the corner points mentioned in lines 1 and 2 above were in conformance with regulations and rules therefore as required in the current manual of survey instructions of the United States Department of the Interior, Bureau of Land Management or by a decree of a Court of Law and/or that the corner points mentioned in lines 3, 4 and 5 above were in conformance with the rules of the Michigan Board of Land Surveyors or by a Decree of a Court of Law; established, re-established, monumented, re-monumented, recovered, found as expressed below:

NOTE: Not more than 4 corners, all in the same town and range, may be recorded on this certificate.

A. Description of original monument and accessories and/or subsequent restoration:

- 1834 (Gov't. Land Office Notes) Harvey Parke, D.S. -set quarter section post-Hemlock 7 N41E 27; Hemlock 7 N49W 15
- 1973 (Land Corner Recordation Certificate) David T. Rowe, P.S. 11192 -set "T" iron at intersection of fence line and Centerline of Road extended- NW 80.41' Nail and Cap in PP; SW 11.59' Nail and Cap in PP; North 45.12' Steel anchor post
- 1973 (Survey-Liber 434, page 674) Robert G. Kay P.S. #14096 -no identification of object found/sec N45°W 80.41' Nail & Cap P.P.; North 45.12' Steel "A" Post; N45°E 79.59' SW Cor House
- 1973 (Survey-Liber 435, pages 707 & 708) David T. Rowe, P.S. #11192 -Found "T" iron- NW, 80.41' Nail & Cap in PP; North, 45.12' Steel "A" Post; NE, 79.59' SW Cor of House #4283

(Continued on the back of this form)

B. Description of corner evidence found and/or method applied in restoring or reestablishing corner:

Found "T" iron and accessories in place and accepted "T" iron as marking original corner

C. Description of monument for corner and accessories established to perpetuate locating the position of the corner:


- Removed "T" iron and replaced with Standard Tuscola County Concrete Monument w/2" Brass Cap stamped J13 T11N-R10E
- North, 45.33'-Angle iron fence post set in concrete
- North, 18.3'+-Centerline of Pavement
- S35°E, 49.72'-T.C. Remon. tag in Southwest face of 9" Box Elder
- S20°W, 95.59'-T.C. Remon. tag over found nail in East face of Power Pole
- S75°W, 11.60'-T.C. Remon. tag over found nail in Southeast face of Power Pole
- N30°W, 78.45'-T.C. Remon. tag in Southwest face of Telephone Pole
- South, 1.0' -Fiberglass "Survey Marker" witness post

	A	B	C	D	E	F	G	H	I	J	K	L	M
2	6		5		4		3		2		1		
3													
4	7		8		9		10		11		12		
5													
6	18		17		16		15		14		13		
7													
8	19		20		21		22		23		24		
9													
10	30		29		28		27		26		25		
11													
12	31		32		33		34		35		36		
13													

Signed by Lionel Roy Emery
Surveyor's Michigan License No. 24593

Date October 4, 1994


APPROVED
8-8-94

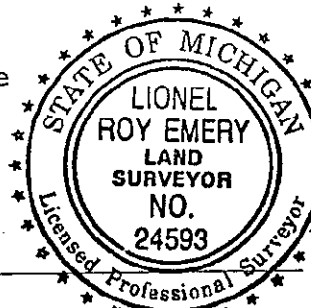

Section A. (continued)

1988 (Survey -for Robert Wilson) Harold N. Elrich, P.S. #18986 -Found "T" iron- S80°W 11.60' pole; South 95.65' pw'r. pole; North, 45.36' enc. post

1988 (Survey -for Ernest Whittie) Earl E. Grävlin, P.S.#23510 -Found "T" iron- N45°W 80.41' PP; North 45.11' Steel "A" post; N45°E 79.59' SW cor. House

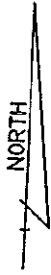

NO SCALE

