

SURVEY &
REMONUMENTATION

OCT 20 1994

1994 REMONUMENTATION PROGRAM
LAND CORNER RECORDATION CERTIFICATE
Filing Requirement of Act 74, Mich. P.A. 1970

COMMISSION

For corners in DAYTON TOWNSHIP

RECEIVED FOR RECORD
LIBERNO. _____ PAGE NO. _____
FILING NO. #58
DAYTON TWP
94 OCT -4 AM 10:33
VIRGINIA H. HALLAHER
TUSCOLA COUNTY
REGISTER OF DEEDS

<u>TUSCOLA</u> (County)	Located In:	Corner Code #
1. Public Land Survey	T 11N. R 10E	K-13
	T _____ R _____	_____
	T _____ R _____	_____
	T _____ R _____	_____
2. Property Controlling in Section	S _____ T _____ R _____	_____
	S _____ T _____ R _____	_____
3. Miscellaneous Property in Sec.	S _____ T _____ R _____	_____
	S _____ T _____ R _____	_____
4. Lot No. _____, Recorded Plat _____		
5. Private Claims _____		

Register of Deeds Stamp & File Number

A	B	C	D	E	F	G	H	I	J	K	L	M
2	6		5		4		3		2		1	
3												
4	7		8		9		10		11		12	
5												
6	18		17		16		15		14		13	
7												
8	19		20		21		22		23		24	
9												
10	30		29		28		27		26		25	
11												
12	31		32		33		34		35		36	
13												


Lionel Roy Emery in a field survey on May 27, 1994, do hereby certify that under requirements of P.A. 74, Michigan P.A. of 1970, the corner points mentioned in lines 1 and 2 above were in conformance with regulations and rules therefore as required in the current manual of survey instructions of the United States Department of the Interior, Bureau of Land Management or by a decree of a Court of Law and/or that the corner points mentioned in lines 3, 4 and 5 above were in conformance with the rules of the Michigan Board of Land Surveyors or by a Decree of a Court of Law; established, re-established, monumented, re-monumented, recovered, found as expressed below:

NOTE: Not more than 4 corners, all in the same town and range, may be recorded on this certificate.

A. Description of original monument and accessories and/or subsequent restoration:
1834 (Gov't. Land Office Notes) Harvey Parke, D.S. - set post cor. Sections 35, 36- Pine 30 N62E 5; Hemlock 10 N27W 7
1987 (Survey- Liber 573, pages 1497 and 1498) Russell L. Brown, P.S. 24588 -found 3/4" steel stake- N. 121.6' nail E. side of Util. Pole; East 19.22' nail in N. side of Anchor Pole; N70°W 33.52' nail S. side of Util. Pole

B. Description of corner evidence found and/or method applied in restoring or reestablishing corner:
found 1" diameter by 18" long iron reinforcing bar and accessories as per Brown's survey.
Accepted iron bar as marking original corner.

C. Description of monument for corner and accessories established to perpetuate locating the position of the corner:
Removed iron bar and replaced with Standard Tuscola County Concrete Monument w/2" Brass Cap stamped K13 T11N R10E (Note: Monument position is in Easterly fill slope of Maple Grove Road East, 21.70'-T.C. Remon. tag in South face of Guy pole S55°W, 28.41'-set 1/2" iron rerod in Easterly shoulder of Maple Grove Road N65°W, 33.53'-T.C. Remon. tag over found nail in South fce of power pole N08°W, 121.68'-T.C. Remon. tag over found nail in East face of power pole North, 1.0' - Fiberglass "Survey Marker" witness post

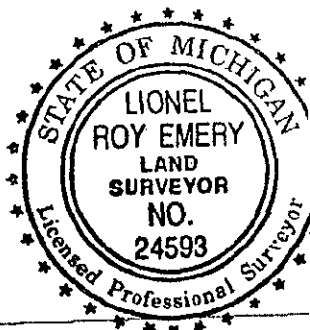

Signed by Lionel Roy Emery Date October 4, 1994
Surveyor's Michigan License No. 24593

APPROVED
8-2-94
[Signature]

