

**1996 REMONUMENTATION PROGRAM
LAND CORNER RECORDATION CERTIFICATE
Filing Requirement of Act 74, Mich. P.A. 1970**

For corners in Dayton Twp.

Tuscola Located In: _____ Corner Code # _____
(County)

1. Public Land Survey T11NR 10E M-2
T R
T11NR 11E A-2
T R

2. Property Controlling _____
in Section S T R
S T R

3. Miscellaneous _____
Property in Sec. S T R
S T R

RECEIVED FOR RECORD
LIBER NO. _____ PAGE NO. 90
FILE NO. Dayton
95 DEC 10 PM 4:50
TUSCOLA COUNTY
REGISTER OF DEEDS
Register of Deeds Stamp & File Number

4. Lot No. _____, Recorded Plat _____
5. Private Claims _____

I, Kenneth D. Dunton in a field survey on May 11, 1996 do hereby state that under requirements of P.A. 74, Michigan P.A. of 1970, the corner points mentioned in lines 1 and 2 above were in conformance with regulations and rules therefore as required in the current manual of survey instructions of the United States Department of the Interior, Bureau of Land Management or by a decree of a Court of Law and/or that the corner points mentioned in lines 3, 4 and 5 above were in conformance with the rules of the Michigan Board of Land Surveyors or by a Decree of a Court of Law; established, re-established, monumented, recovered, found as expressed below:

NOTE: Not more than 2 corners, all in the same town and range, may be recorded on this certificate.

A	B	C	D	E	F	G	H	I	J	K	L	M
1												
2	6	5	4	3	2	1						
3												
4	7	8	9	10	11	12						
5												
6	18	17	16	15	14	13						
7												
8	19	20	21	22	23	24						
9												
10	30	29	28	27	26	25						
11												
12	31	32	33	34	35	36						
13												

A. Description of original monument and accessories and/or subsequent restoration:

GLO 1834	Nov. 3, 1882	Apr. 14, 1886
Harvey Parke, D.S.	John A. Teskey, Co. Surveyor	John A. Teskey, Co. Surveyor,
Set Quarter Sec. Post	Sec. 1, T11N-R10E, Pages 28 & 29	Sec. 6, T11N-R11E,
Hemlock 9 S39W 14	Establish proportionate distance	Pages 46 & 47. See E 1/4
Beech 17 N42W31	from corners. Stone and crockery.	cor. Sec. 1, Dayton,
	Aspin N65 1/2 E 70 3/4	Page 28

Note: Section A continued on back of form.

B. Description of corner evidence found and/or method applied in restoring or reestablishing corner:

Found 1/2" rod. Held as the best evidence of the original corner.


C. Description of monument for corner and accessories established to perpetuate locating the position of the corner:

Removed 1/2" rod & placed standard monument stamped Corner M-2, T11N-R10E.
S85°W 32.24' ind. spike & tag #37276 in E. face 24" Maple.
N68°W 36.86' ind. spike & tag #37276 in S. face 25" Maple.
N70°E 24.40' ind. spike & tag #37276 in N. face 6" Elm.
S40°E 34.21' set T.C. Remon. tag & spike in SW face 3" Maple.

Note: This corner is common with A-2, T11N-R11E.

Signed by [Signature]
Surveyor's Michigan License No. 23503

Date 12-4-96

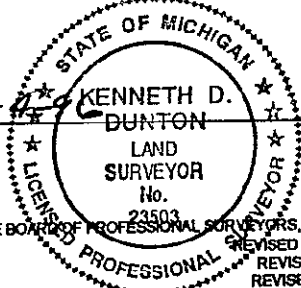

APPROVED
12-4-96
RBB
J.H.E.

FORM APPROVED BY MICHIGAN STATE BOARD OF PROFESSIONAL SURVEYORS, JAN. 28, 1971
REVISED MAY 14, 1975
REVISED JAN. 1983
REVISED OCT., 1985

July, 1963 M.S.H.D. witness card Cor. A-2, T11N-R11E
by H. G. McManus, Survey Chief.

3/4" Iron.
West 33.65' 18" Maple.
N60°W 37.31' 20" Maple.
East 26.74' fence post.

Aug. 23, 1974

Survey by David T. Rowe, Land Surveyor #11192, Liber 443-Page 850.
1/2" Re-rod.

West 33.65' RLS tag 11192 in 20" Maple.
N60°W 37.31' RLS tag 11192 in 24" Maple.

April 20, 1979

Survey by Charles S. Getz, Land Surveyor #25843, Liber 304-Pages 1069 & 1070.
Fnd. 1/2" Iron.

West 33.65' 18" Maple.
N60°W 37.31' 20" Maple.
N30°W 61.30' nail 12" Pear.

Dec. 1, 1983

Survey by Richard R. Boldt, Land Surveyor #28405, Liber 539-Pages 851 & 852.
Fnd. 1/2" Iron (common to W 1/4 Cor. Sec. 6, T11N-R11E)

S15°E 129.94' set spike w/cap in 22" Maple.
West 33.50' set spike in blaze on S. face 24" Maple.
N75°W 37.16' set spike in blaze on S. face 24" Maple.

Dec. 22, 1983

L.C.R.C. form filed by Richard R. Boldt, Land Surveyor #28405 Page 46, Dayton
Twp.

Same object & accessories as Liber 539-Pages 851 & 852.

Sept. 13, 1995

Survey by Jonathan M. Field, Land Surveyor #37276, Liber 683-Pages 22, 23 & 24
Fnd. 1/2" rod.

West 32.14' set nail w/tag #37276 in E. face 24" Maple.
N70°W 36.86' set nail w/tag #37276 in SE face 32" Maple.
N20°W 108.01' set nail w/tag #37276 in E. face mailbox post.
N60°E 24.40' set nail w/tag #37276 in N. face 8" Elm.

