

1996 REMONUMENTATION PROGRAM  
 LAND CORNER RECORDATION CERTIFICATE  
 Filing Requirement of Act 74, Mich. P.A. 1970

For corners in Dayton Twp.

Tuscola Located In: \_\_\_\_\_ Corner Code # \_\_\_\_\_  
 (County)

1. Public Land Survey T 11N R 10E M-5 ✓  
 T \_\_\_\_\_ R \_\_\_\_\_  
 T \_\_\_\_\_ R \_\_\_\_\_  
 T 11N R 11E A-5  
 2. Property Controlling S \_\_\_\_\_ T \_\_\_\_\_ R \_\_\_\_\_  
 in Section S \_\_\_\_\_ T \_\_\_\_\_ R \_\_\_\_\_  
 3. Miscellaneous S \_\_\_\_\_ T \_\_\_\_\_ R \_\_\_\_\_  
 Property in Sec. S \_\_\_\_\_ T \_\_\_\_\_ R \_\_\_\_\_

RECEIVED FOR RECORD  
 LIBER NO. \_\_\_\_\_ PAGE NO. 87  
 FILE NO. Dayton  
 96 DEC 10 PM 4:50  
 TUSCOLA COUNTY  
 REGISTER OF DEEDS

Register of Deeds Stamp & File Number

4. Lot No. \_\_\_\_\_, Recorded Plat \_\_\_\_\_  
 5. Private Claims \_\_\_\_\_

I, Kenneth D. Dunton in a field survey on May 19, 19 96 do hereby state that under requirements of P.A. 74, Michigan P.A. of 1970, the corner points mentioned in lines 1 and 2 above were in conformance with regulations and rules therefore as required in the current manual of survey instructions of the United States Department of the Interior, Bureau of Land Management or by a decree of a Court of Law and /or that the corner points mentioned in lines 3, 4 and 5 above were in conformance with the rules of the Michigan Board of Land Surveyors or by a Decree of a Court of Law; established, re-established, monumented, recovered, found as expressed below:

NOTE: Not more than 2 corners, all in the same town and range, may be recorded on this certificate.

	A	B	C	D	E	F	G	H	I	J	K	L	M
1													
2		6		5		4		3		2		1	
3													
4		7		8		9		10		11		12	
5													
6		19		17		16		15		14		13	
7													
8		19		20		21		22		23		24	
9													
10		30		29		28		27		26		25	
11													
12		31		32		33		34		35		36	
13													

A. Description of original monument and accessories and/or subsequent restoration:

GLO 1834 Date of survey unknown.  
 Harvey Parke, D.S. Edward Teskey, County Surveyor 1895-1898  
 Set post cor. Secs. 12 & 13 Section 7, T11N-R11E  
 Hemlock 28 S 37 W 44 1/2 Stake at O  
 Hemlock 18 N 4 W 8 Maple S45E 55  
 School house SW 1.43

Note: Section A continued on back of form.

B. Description of corner evidence found and/or method applied in restoring or reestablishing corner:

Found 1/2" rod in 1" pipe. Held as the best evidence of the original corner.


C. Description of monument for corner and accessories established to perpetuate locating the position of the corner:

Removed 1/2" rod & 1" pipe and placed standard monument stamped M-5, T11N-R10E.  
 S45°E 62.24' set T.C. Remon. tag & spike in S. face 10" Pine.  
 N22°W 23.31' set T.C. Remon. tag & spike in E. face 24" Maple.  
 N64°E 46.49' set T.C. Remon. tag & spike in NW face T. pole (new).  
 S42°E 70.37' fnd. 11192 tag & nail in NW face P. pole.  
 S37°E 38.80' set T.C. Remon. tag & spike in SW face 24" Maple.

Note: This corner is common with A-5, T11N-R11E.

Signed by [Signature]  
 Surveyor's Michigan License No. 23503

Date 11-11-96

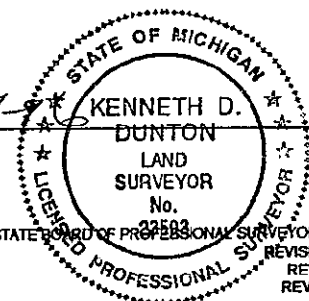

APPROVED  
11-11-96  
[Signature]

FORM APPROVED BY MICHIGAN STATE BOARD OF PROFESSIONAL SURVEYORS, JAN. 28, 1971  
 REVISED MAY 14, 1975  
 REVISED JAN., 1983  
 REVISED OCT., 1995

MAY 20 1997

COMMUNITY...

May, 1973  
 L.C.R.C. filed by David T. Rowe, Land Surveyor #11192; Page 22, Dayton Twp.  
 Found nothing from excavation. Set 1" pipe 30" long from survey Liber 1,  
 P-38 and occupation of road East & West.  
 N75°E 45.85' RLS 11192 tag in T.P.  
 S45°E 70.35' RLS 11192 tag in P.P.  
 S20°E 73.55' RLS 11192 tag in 24" Maple.

June 27, 1973  
 Survey by David T. Rowe, Land Surveyor #11192, Liber 436-Pages 267 & 268.  
 1" pipe. Same accessories as L.C.R.C. page 22.

Jan. 15, 1975  
 Survey by Robert G. Kay, Land Surveyor #14096, Liber 447, Pages 230 & 231.  
 No mention of object found or set or accessories.

Aug. 18, 1980  
 Survey by Earl E. Gravlin, Land Surveyor #23510, Liber 508, Page 1092 & 1093  
 No mention of object found.  
 N75°E 45.85' nail T.P.  
 S45°E 70.35' nail P.P.  
 S20°E 73.55' nail 24" Maple.  
 N10°W 47.38' nail 24" Maple.

Oct. 5, 1984  
 Survey by Earl E. Gravlin, Land Surveyor #23510, Liber 545-Page 1292.  
 Fnd. 1" pipe.  
 N40°W 23.25' 24" Maple.  
 N50°E 46.14' T.P.  
 S45°E 38.89' 24" Maple.

July 22, 1993  
 Earl E. Gravlin, Land Surveyor #23510 unrecorded survey job #93641  
 No mention of object found or set or accessories.

