

1996 REMONUMENTATION PROGRAM
 LAND CORNER RECORDATION CERTIFICATE
 Filing Requirement of Act 74, Mich. P.A. 1970

For corners in Dayton Twp.

<u>Tuscola</u> (County)	Located In:	Corner Code #
1. Public Land Survey	T11NR 10E	M-6 ✓
	T R	
	T11NR 11E	A-6
	T R	
2. Property Controlling in Section	S T R	
	S T R	
3. Miscellaneous Property in Sec.	S T R	
	S T R	

RECEIVED FOR RECORD
 LIBER NO. _____ PAGE NO. 86
 FILE NO. Dayton
 96 DEC 10 PM 4:50
 TUSCOLA COUNTY REGISTER OF DEEDS
 Register of Deeds Stamp & File Number

4. Lot No. _____, Recorded Plat _____
 5. Private Claims _____

I, Kenneth D. Dunton, in a field survey on May 19, 1996 do hereby state that under requirements of P.A. 74, Michigan P.A. of 1970, the corner points mentioned in lines 1 and 2 above were in conformance with regulations and rules therefore as required in the current manual of survey instructions of the United States Department of the Interior, Bureau of Land Management or by a decree of a Court of Law and/or that the corner points mentioned in lines 3, 4 and 5 above were in conformance with the rules of the Michigan Board of Land Surveyors or by a Decree of a Court of Law; established, re-established, monumented, recovered, found as expressed below:

A	B	C	D	E	F	G	H	I	J	K	L	M
1												
2	6	5	4	3	2	1						
3												
4	7	8	9	10	11	12						
5												
6	18	17	16	15	14	13						
7												
8	19	20	21	22	23	24						
9												
10	30	29	28	27	26	25						
11												
12	31	32	33	34	35	36						
13												

NOTE: Not more than 2 corners, all in the same town and range, may be recorded on this certificate.

A. Description of original monument and accessories and/or subsequent restoration:

GLO 1834 May 19, 1971
 Harvey Parke, D.S. Survey by Carl H. Carlson, Land Surveyor #9189,
 Set Quarter Sec. Post Liber 1-Page 38. No mention of evidence found or set
 Beech 16 N 54 W 14 1/2 or accessories.
 Hemlock 9 S 19 W 28 Jan. 15, 1975
 Survey by Robert G. Kay, Land Surveyor #14096, Liber
 Note: Section A continued on back of form. 447-Pages 230 & 231. N40°W 55.64' nail 20" Maple.
 West 42.11' nail 30" Maple.

B. Description of corner evidence found and/or method applied in restoring or reestablishing corner: S70°E 32.42' tele. junction box.
 Found 1/2" rod. Held as the best evidence of the original corner.

C. Description of monument for corner and accessories established to perpetuate locating the position of the corner:


Removed 1/2" rod and placed standard monument stamped M-6, T11N-R10E.
 S82°W 29.84' set T.C. Remon. tag in S. face cor. post.
 N89°W 42.14' set T.C. Remon. tag in N. root Maple.
 N87°E 31.60' set T.C. Remon. tag in S. face 2" wood post.
 S35°E 60.52' set T.C. Remon. tag in SW face P. pole.
 S64°E 32.11' NW cor. tele. junction box.

Note: This corner is common with A-6, T11N-R11E.

Signed by Kenneth D. Dunton
 Surveyor's Michigan License No. 23503

Date 11-11-96

APPROVED
 11-11-96
[Signatures]

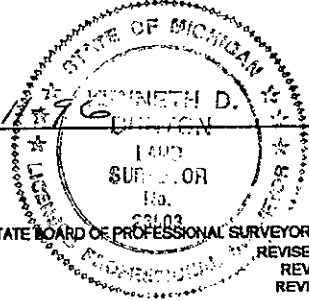

FORM APPROVED BY MICHIGAN STATE BOARD OF PROFESSIONAL SURVEYORS, JAN. 28, 1971
 REVISED MAY 14, 1975
 REVISED JAN., 1983
 REVISED OCT., 1985

MAY 20 1997

Oct. 5, 1984

Survey by Earl E. Gravlin, Land Surveyor #23510, Liber 545, Page 1292.

1/2" iron.

West 42.26' 30" Maple.

N30°W 70.65' 24" Maple.

South 3.63 E 1/4 cor. Sec. 13.

