

1996 REMONUMENTATION PROGRAM  
LAND CORNER RECORDATION CERTIFICATE  
Filing Requirement of Act 74, Mich. P.A. 1970

For corners in Dayton Twp.

<u>Tuscola</u> (County)	Located in:	Corner Code #
1. Public Land Survey	T <u>11</u> N R <u>10</u> E	<u>M-7</u> ✓
	T <u>11</u> N R <u>11</u> E	<u>A-7</u>
2. Property Controlling in Section	S <u>    </u> T <u>    </u> R <u>    </u>	_____
3. Miscellaneous Property in Sec.	S <u>    </u> T <u>    </u> R <u>    </u>	_____

RECEIVED FOR RECORD  
LIBER NO. \_\_\_\_\_ PAGE NO. 85  
FILE NO. Dayton  
56 DEC 10 PM 4:50  
TUSCOLA COUNTY REGISTER OF DEEDS  
Register of Deeds Stamp & File Number

4. Lot No. \_\_\_\_\_, Recorded Plat \_\_\_\_\_  
5. Private Claims \_\_\_\_\_

I, Kenneth D. Dutton in a field survey on May 19, 1996 do hereby state that under requirements of P.A. 74, Michigan P.A. of 1970, the corner points mentioned in lines 1 and 2 above were in conformance with regulations and rules therefore as required in the current manual of survey instructions of the United States Department of the Interior, Bureau of Land Management or by a decree of a Court of Law and for that the corner points mentioned in lines 3, 4 and 5 above were in conformance with the rules of the Michigan Board of Land Surveyors or by a Decree of a Court of Law, established, re-established, monumented, recovered, found as expressed below:

A	B	C	D	E	F	G	H	I	J	K	L	M
1												
2	6	5	4	3	2	1						
3												
4	7	8	9	10	11	12						
5												
6	18	17	16	15	14	13						
7												
8	19	20	21	22	23	24						
9												
10	30	29	28	27	26	25						
11												
12	31	32	33	34	35	36						
13												

NOTE: Not more than 2 corners, all in the same town and range, may be recorded on this certificate.

A. Description of original monument and accessories and/or subsequent restoration:  
GLO 1834 Mar. 27, 1891  
Harvey Parke, D.S. G.B. Felton, County Surveyor  
Set post corner Secs. 13 & 14 Section 24 T11N-R10E  
Birch 24 N17 1/1 W43 Previously established from  
Hemlock 9 S 25 W 20 B.T.'s  
Sugar 6 S84 1/2 W S30  
Cedar post, glass & crockery cor.

Note: Section A continued on back of form.

B. Description of corner evidence found and/or method applied in restoring or reestablishing corner:  
Found 1/2" rod (bent). Held as the best evidence of the original corner.


C. Description of monument for corner and accessories established to perpetuate locating the position of the corner:  
Removed 1/2" rod and placed standard monument stamped M-7, T11N-R10E.  
S57°W 37.12' chiseled notch atop S. end 40' of 15" CSP.  
N43°E 60.74' set T. C. Remon. tag & spike in NW face P. pole.  
S70°E 57.49' set T. C. Remon. tag & spike in SW face 14" Pine.  
N88°E 32.80' fnd. 1/4" rod & cap #1--96.

Note: This corner is common with A-7, T11N-R11E.

Signed by [Signature]  
Surveyor's Michigan License No. 23503

Date 11-11-96

APPROVED  
11-11-96  
[Signature]

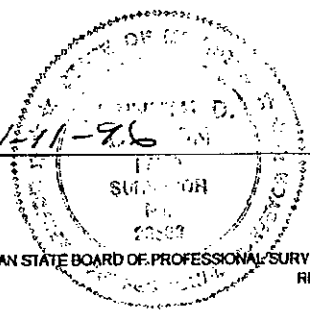

May, 1973

L.C.R.C. form filed by David T. Rowe, Land Surveyor #11192; Page 20, Dayton Twp.  
Fnd. 1/2" re-rod.

N40°E 64.43' RLS 11192 tag in P.P.  
S70°W 86.67' RLS 11192 tag in 30" Maple.  
S55°W 37.10' "X" in road sign post.

June 21, 1973

Survey by David T. Rowe, Land Surveyor #11192, Liber 433-Pages 134 & 135  
Fnd. 1/2" re-rod  
Same accessories as L.C.R.C. Page 20.

Jan. 15, 1975

Survey by Robert G. Kay, Land Surveyor #14096, Liber 447-Pages 230 & 231.  
1/2" iron.  
N50°E 60.58' nail P.P.  
S70°W 88.03' nail 26" Maple.  
S60°W 39.93' road sign.

Feb. 17, 1976

Survey by Robert G. Kay, Land Surveyor #14096, Liber 457-Page 944  
Same object and accessories as L-447, P-230 & 231.

Oct. 5, 1984

Survey by Earl E. Gravlin, Land Surveyor #23510, Liber 545-Page 1292  
Fnd. 1/2" iron  
Same accessories as L-457, P-944

Dec. 9, 1988

L.C.R.C. form filed by Ray D. Davis, Land Surveyor #22430  
Fnd. 1/2" iron using local recorded surveys and corner records.  
N40°E 64.43' tag in P. pole.  
S55°W 37.10' crossroad sign.  
S70°W 86.67' tag in 30" Maple.  
North 5.65' 1/2" iron. North

