

**1996 REMONUMENTATION PROGRAM
LAND CORNER RECORDATION CERTIFICATE
Filing Requirement of Act 74, Mich. P.A. 1970**

For corners in Dayton Twp.

<u>Tuscola</u> (County)	Located In:	Corner Code #
1. Public Land Survey	T <u>11N</u> R <u>10E</u>	<u>M-9</u>
	T <u>11N</u> R <u>11E</u>	<u>A-9</u>
2. Property Controlling in Section	S <u> </u> T <u> </u> R <u> </u>	<u> </u>
3. Miscellaneous Property in Sec.	S <u> </u> T <u> </u> R <u> </u>	<u> </u>

TUSCOLA COUNTY REGISTER OF DEEDS

RECEIVED FOR RECORD
LIBER NO. _____ PAGE NO. 83
FILE NO. Dayton
26 DEC 10 PM 4:50

Register of Deeds Stamp & File Number

4. Lot No. _____, Recorded Plat _____
5. Private Claims _____

I, Kenneth D. Dunton in a field survey on May 18, 1996 do hereby state that under requirements of P.A. 74, Michigan P.A. of 1970, the corner points mentioned in lines 1 and 2 above were in conformance with regulations and rules therefore as required in the current manual of survey instructions of the United States Department of the Interior, Bureau of Land Management or by a decree of a Court of Law and for that the corner points mentioned in lines 3, 4 and 5 above were in conformance with the rules of the Michigan Board of Land Surveyors or by a Decree of a Court of Law; established, re-established, monumented, recovered, found as expressed below:

NOTE: Not more than 2 corners, all in the same town and range, may be recorded on this certificate.

A	B	C	D	E	F	G	H	I	J	K	L	M
1												
2	6		5		4		3		2		1	
3												
4	7		8		9		10		11		12	
5												
6	10		17		16		15		14		13	
7												
8	19		20		21		22		23		24	
9												
10	30		29		28		27		26		25	
11												
12	31		32		33		34		35		36	
13												

A. Description of original monument and accessories and/or subsequent restoration:

G.L.O. 1834 Harvey Parke, D.S. Set Post Cor. Secs. 24 & 25 Cedar 14 S26W 18 Hemlock N52W 11	Mar. 27, 1891 G. B. Felton, Co. Surveyor Sec. 24, T11N-R10E Previously set from B.T.'s Cedar 12 N12W 89 1/2 Cedar 14 N3 1/2W 182 1/2	Feb. 1922 A.D. Road #14 Plans Section cor. shown. No object or accessories given.
---	---	--

Note: Section A continued on back of form

B. Description of corner evidence found and/or method applied in restoring or reestablishing corner:

Found 1/2" rod in monument box. Held as the best evidence of the original corner.


C. Description of monument for corner and accessories established to perpetuate locating the position of the corner:

Removed 1/2" rod and placed 5/8" rod and standard brass cap stamped M-9, T11N-R10E. Encased rod & cap in concrete in mon. box.
S42°W 28.97' set 3/4" pipe & cap #23503 in road shoulder.
N22°W 79.96' Fnd. notch chiseled atop W. end of 50' of 24" CMP.
N15°E 78.25' Fnd. notch chiseled atop E. end of 50' of 24" CMP.
N34°E 42.25' Fnd. notch chiseled atop N. end of 63' of 36" CMP.

Note: This corner is common with A-9, T11N-R11E.

Signed by [Signature]
Surveyor's Michigan License No. 23503

Date 11-11-96

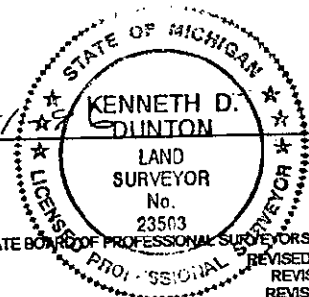

APPROVED
11-11-96
[Signature]

FORM APPROVED BY MICHIGAN STATE BOARD OF PROFESSIONAL SURVEYORS, JAN. 28, 1971
REVISED MAY 14, 1975
REVISED JAN., 1983
REVISED OCT., 1985

REMONUMENT

MAY 20 1997

COMM...

29

May 25, 1973

Survey by David T. Rowe, Land Surveyor #11192, Liber 507-Page 608
No mention of object found or set or accessories.

July, 1973

L.C.R.C. form filed by David T. Rowe, Land Surveyor #11192, Page 24, Dayton Twp.

Set 1/2" re-rod as occupied on centerline, centerline roads.

S30°E 33.95' X on stop sign post.

S80°E 76.80' X on "soft shoulder" sign.

N30°W 35.10' X on stop sign post.

June 16, 1976

Survey by Irvin E. Chope, Land Surveyor #6504, Liber 472-Pages 847 through 851.
No mention of object fnd. or set or accessories.

Dec. 9, 1988

L.C.R.C. form filed by Ray D. Davis, Land Surveyor #22430, Page 48, Dayton Twp.
Fnd. iron 1' below asphalt surface, set iron at surface of asphalt.

S25°E 35.96' stop sign.

N45°E 66.76' P.K. nail in 18" tree.

N30°W 69.90' P.K. nail in P.P.

Dec. 12, 1988

Survey by Ray D. Davis, Land Surveyor #22430, Liber 589-Pages 236 & 237.
1/2" iron rod in asphalt pavement. Same accessories as L.C.R.C. Page 48.

April 17, 1995

Survey by Earl E. Gravlin, Land Surveyor #23510, Liber 681-Pages 1408 & 1409.

Fnd. 1/2" re-rod.

N45°E 42.30' 36" CMP.

S20°E 36.0' stop sign.

N35°W 39.48' stop sign.

