

1996 REMONUMENTATION PROGRAM
LAND CORNER RECORDATION CERTIFICATE
 Filing Requirement of Act 74, Mich. P.A. 1970

For corners in Dayton Twp.

<u>Tuscola</u> (County)	Located In:	Corner Code #
1. Public Land Survey	T <u>11N</u> R <u>10E</u>	<u>M-10</u> ✓
	T <u>11N</u> R <u>11E</u>	<u>M-10</u>
2. Property Controlling in Section	S <u> </u> T <u> </u> R <u> </u>	_____
3. Miscellaneous Property in Sec.	S <u> </u> T <u> </u> R <u> </u>	_____

4. Lot No. _____, Recorded Plat _____
 5. Private Claims _____

I, Kenneth D. Duntop in a field survey on May 18, 1996 do hereby state that under requirements of P.A. 74, Michigan P.A. of 1970, the corner points mentioned in lines 1 and 2 above were in conformance with regulations and rules therefore as required in the current manual of survey instructions of the United States Department of the Interior, Bureau of Land Management or by a decree of a Court of Law and/or that the corner points mentioned in lines 3, 4 and 5 above were in conformance with the rules of the Michigan Board of Land Surveyors or by a Decree of a Court of Law; established, re-established, monumented, recovered, found as expressed below:

NOTE: Not more than 2 corners, all in the same town and range, may be recorded on this certificate.

A. Description of original monument and accessories and/or subsequent restoration:

G.L.O. 1834
 Harvey Parke, D.S.
 Set Quarter Section Post
 Cedar 6 N29W 10
 Hemlock 28 S52W 17

B. Description of corner evidence found and/or method applied in restoring or reestablishing corner:

Found 1/2" rod in centerline road between occupied fences E & W. Held rod as best evidence of original corner.

C. Description of monument for corner and accessories established to perpetuate locating the position of the corner:


Removed 1/2" rod & placed standard monument stamped corner M-10, T11N-R10E.
 S65°W 31.56' set T. C. Remon. tag & spike in SE face 15" Ash.
 West 44.37' set T. C. Remon. tag & spike in N. face Cedar.
 East 21.64' set T. C. Remon. tag & spike in N. face new cor. post.
 S55°E 25.23' set T. C. Remon. tag & spike in SW face fence post.

Note: This corner is common with A-10, T11N-R11E.

Signed by *[Signature]*
 Surveyor's Michigan License No. 23503

Date _____

APPROVED
11-11-96
[Signatures]

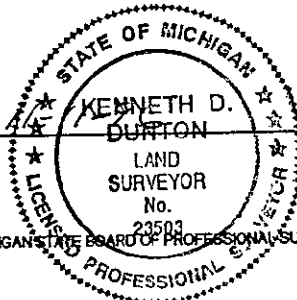

FORM APPROVED BY MICHIGAN STATE BOARD OF PROFESSIONAL SURVEYORS, JAN. 28, 1971
 REVISED MAY 14, 1975
 REVISED JAN., 1983
 REVISED OCT., 1995

RECEIVED FOR RECORD
 INDEX NO. _____ PAGE NO. 82
 FILE NO. Dayton
 96 DEC 10 PM 4:50
 Tuscola County
 REGISTER OF DEEDS
 Register of Deeds Stamp & File Number

A	B	C	D	E	F	G	H	I	J	K	L	M
1												
2	6		5		4		3		2		1	
3												
4	7		8		9		10		11		12	
5												
6	18		17		16		15		14		13	
7												
8	19		20		21		22		23		24	
9												
10	30		29		28		27		26		25	
11												
12	31		32		33		34		35		36	
13												

REMONUMENTATION
 MAY 20 1997
 COMMISSION

20

North

Section 25, T11N-R10E

Section 30, T11N-R11E

