

1996 REMONUMENTATION PROGRAM
 LAND CORNER RECORDATION CERTIFICATE
 Filing Requirement of Act 74, Mich. P.A. 1970

For corners in Dayton Twp.

Tuscola Located In: _____ Corner Code # _____
 (County)

1. Public Land Survey T 11N R 10E M-11
 T _____ R _____
 T 11N R 11E A-11
 T _____ R _____

2. Property Controlling in Section S _____ T _____ R _____
 S _____ T _____ R _____

3. Miscellaneous Property in Sec. S _____ T _____ R _____
 S _____ T _____ R _____

4. Lot No. _____, Recorded Plat _____
 5. Private Claims _____

I, Kenneth D. Dunton in a field survey on May 11, 1996 do hereby state that under requirements of P.A. 74, Michigan P.A. of 1970, the corner points mentioned in lines 1 and 2 above were in conformance with regulations and rules therefore as required in the current manual of survey instructions of the United States Department of the Interior, Bureau of Land Management or by a decree of a Court of Law and /or that the corner points mentioned in lines 3, 4 and 5 above were in conformance with the rules of the Michigan Board of Land Surveyors or by a Decree of a Court of Law; established, re-established, monumented, recovered, found as expressed below:

NOTE: Not more than 2 corners, all in the same town and range, may be recorded on this certificate.

A. Description of original monument and accessories and/or subsequent restoration:

G.L.O. 1834	Aug. 23, 1882
Harvey Parke. D.S.	John A. Teskey, Co. Surveyor
Set Post Cor. Secs. 25 & 36	Sec. 31 T11N-R11E
Hemlock 20 N14W 18	Hemlock 20 N14W 18
Beech 16 S55W 14	Maple 2 S 22 3/4E 106 1/2
	Cherry 2. N42 1/2W 93 1/2

Section A continued on back of form.

B. Description of corner evidence found and/or method applied in restoring or reestablishing corner:

Found 5/8" rod in 3/4" pipe in rock pile 24" deep.
 Held fnd. rod & pipe as the best evidence of the original corner.


C. Description of monument for corner and accessories established to perpetuate locating the position of the corner:

Removed rod & pipe and placed standard monument stamped M-11, T11N-R10E.
 Placed mon. box over monument.
 S27°W 55.27' set T. C. Remon. tag & spike over spike fnd. in NW face T. pole stub.
 S63°W 111.12' set T. C. Remon. tag & spike in N. face P. pole.
 N63°W 56.79' set T. C. Remon. tag & spike in S. face 42" Maple, fnd. bottle cap & nail in SE face at 55.5'±.
 N55°E 52.88' set T. C. Remon. tag & spike in SE face 36" Maple.
 S55°E 86.38' set T. C. Remon. tag & spike in NE face P. pole, fnd. bottle cap & nail in NW face at 86.1'±.

Note: This corner is common with A-11, T11N-R11E.

Signed by Kenneth D. Dunton Date 11-11-96
 Surveyor's Michigan License No. 23503

APPROVED
11-11-96
K.D.

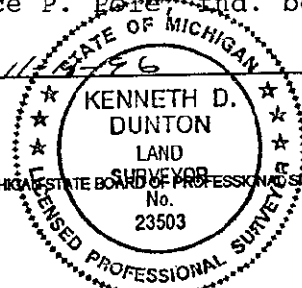

FORM APPROVED BY MICHIGAN STATE BOARD OF PROFESSIONAL SURVEYORS, JAN. 28, 1971
 REVISED MAY 14, 1975
 REVISED JAN., 1983
 REVISED OCT., 1995

RECEIVED FOR RECORD
 LIBER NO. _____ PAGE NO. 81
 FILE NO. Dayton
 56 DEC 10 PM 4:50
 TUSCOLA COUNTY REGISTER OF DEEDS
 Register of Deeds Stamp & File Number

	A	B	C	D	E	F	G	H	I	J	K	L	M
1													
2	6		5		4		3		2		1		
3													
4	7		8		9		10		11		12		
5													
6	18		17		16		15		14		13		
7													
8	19		20		21		22		23		24		
9													
10	30		29		28		27		26		25		
11													
12	31		32		33		34		35		36		
13													

MAY 20 1997

January, 1974

L.C.R.C. form filed by David T. Rowe, Land Surveyor #11192, Page 10, Koylton Township.

Set "T" iron as occupied using fences & road.

Same accessories as L-437, P-347.

Aug. 4, 1977

Survey by Robert G. Kay, Land Surveyor #14096, Liber 476-Pages 948 & 949.

Fnd. "T" iron.

Same accessories as L.C.R.C. Page 10.

Aug. 23, 1978

Survey by Kenneth D. Dunton, Land Surveyor #23503, Liber 490-Page 679.

"T" iron.

Same accessories as L.C.R.C. Page 10 except Maple N45°E labeled as 27".

Sept. 20, 1985

Survey by Earl E. Gravlin, Land Surveyor #23510, Liber 557, Page 793.

Fnd. 1" pipe.

N50°W 55.59' 36" Maple.

N45°E 51.64' 27" Maple.

S50°E 86.01' P.P.

May 7, 1991

Survey by John A. Milletics, Land Surveyor #25859, Liber 614-Page 1000.

No mention of object fnd. or set or accessories.

