

OCT 20 1994

COMMISSION

1994 REMONUMENTATION PROGRAM  
LAND CORNER RECORDATION CERTIFICATE  
Filing Requirement of Act 74, Mich. P.A. 1970

For corners in DAYTON TOWNSHIP

TUSCOLA (County)	Located In:	Corner Code #
1. Public Land Survey	T 11N R 10E	M-13
	T R	
	T R	
	T R	
	T R	
2. Property Controlling in Section	S T R	
	S T R	
3. Miscellaneous Property in Sec.	S T R	
	S T R	

RECEIVED FOR RECORD  
LIBER NO. \_\_\_\_\_ PAGE NO. \_\_\_\_\_  
FILING NO. # 56  
DAYTON TWP.  
91 OCT -4 AM 10:33  
VIRGINIA M. McLAREN  
TUSCOLA COUNTY  
REGISTER OF DEEDS

Register of Deeds Stamp & File Number

- 4. Lot No. \_\_\_\_\_, Recorded Plat \_\_\_\_\_
- 5. Private Claims \_\_\_\_\_

	A	B	C	D	E	F	G	H	I	J	K	L	M
2	6		5		4		3		2		1		
3													
4	7		8		9		10		11		12		
5													
6	18		17		16		15		14		13		
7													
8	19		20		21		22		23		24		
9													
10	30		29		28		27		26		25		
11													
12	31		32		33		34		35		36		
13													

I, Lionel Roy Emery in a field survey on May 27, 1994, do hereby certify that under requirements of P.A. 74, Michigan P.A. of 1970, the corner points mentioned in lines 1 and 2 above were in conformance with regulations and rules therefore as required in the current manual of survey instructions of the United States Department of the Interior, Bureau of Land Management or by a decree of a Court of Law and/or that the corner points mentioned in lines 3, 4 and 5 above were in conformance with the rules of the Michigan Board of Land Surveyors or by a Decree of a Court of Law; established, re-established, monumented, re-monumented, recovered, found as expressed below:

**NOTE: Not more than 4 corners, all in the same town and range, may be recorded on this certificate.**

A. Description of original monument and accessories and/or subsequent restoration:


- 1834 (Gov't. Land Office Notes) Harvey Parke, D.S. -set post cor. Towns 11N-Ranges 10&11 East-Hemlock 12 N39E 12; Hemlock 12 N85W 32; "Marked" Hemlock 12 N39E 12; Hemlock 14 North 11
- 1882 (Tuscola County Surveyor's Record, pages 42 and 43) John A. Teskey, County Surveyor, Survey of Section 31, T11N-R11E identified from Hemlock 12 N85W 32 and perpetuated with "Stake" East 50 links Stake; West 50 links to ?
- 1987 (Survey- Liber 573, pages 1497 and 1498) Russell L. Brown, P.S. #24588- Found 1/2" steel stake S40°E 40.85' Spk. SW side of P.P.; S50°W 51.25' Spk. NW side Anchor Pole; N70°W Spk. S. side of fnc. post

B. Description of corner evidence found and/or method applied in restoring or reestablishing corner:

Found 1/2" diameter reinforcing rod near centerline-centerline intersection of English and Marlette Roads, dug @ CL/CL and explored Subgrade, encountered stains but judged inconclusive as to Teskey's "Stake"  
Accepted found 1/2" rod as marking original corner.

C. Description of monument for corner and accessories established to perpetuate locating the position of the corner:

- Removed 1/2" reinforcing rod and replaced with Standard Tuscola Concrete Monument w/ 2" Brass Cap stamped M13 T11N R10E R11E
- N85°E, 112.21'-T.C. Remon. tag in North face of power pole
- S60°W, 51.20'-T.C. Remon. tag over fnd. nail in N.W. face of guy pole
- N70°W, 73.26'-T.C. Remon. tag over fnd. nail in S.W. face of power pole
- N15°W, 80.16'-T.C. Remon. tag in S.W. face of 30" Cottonwood

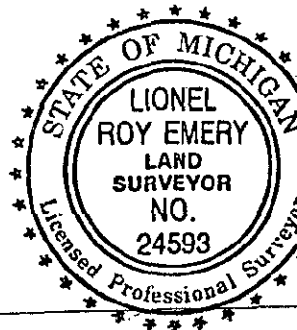


Signed by Lionel Roy Emery

Date October 4, 1994

Surveyor's Michigan License No. 24593

APPROVED  
e-e-94  
gmo  
jmt.

 

NORTH

NO SCALE

DAYTON TWP.  
TIIN-RI0E

KOYLTON TWP.  
TIIN-RIIE

S.E. 1/4 OF SECTION 36

ENGLISH ROAD

S.W. 1/4 OF SECTION 31

L 13

PARKE 1834 2640 FT.  
BROWN 1987 2647.08 FT.  
EMERY 1994 2646.29 FT.

M 13

179°58'28"

PARKE 1834 2640 FT.  
TESKEY 1882 2638.68 FT.  
DUNTON 1994 2633.89 FT.  
EMERY 1994 2633.89 FT.

B 13

(Abandoned) MARLETTE ROAD

SECTION 1, TION-RI0E  
RICH TOWNSHIP  
LAPEER COUNTY

SECTION 6, TION-RIIE  
BURLINGTON TOWNSHIP  
LAPEER COUNTY

