

1996 REMONUMENTATION PROGRAM
 LAND CORNER RECORDATION CERTIFICATE
 Filing Requirement of Act 74, Mich. P.A. 1970

RECEIVED FOR RECORD
 LIBER. NO. _____ PAGE NO. 44
 FILE NO. Koylton
 96 DEC 10 PM 4:48
 TUSCOLA COUNTY
 REGISTER OF DEEDS

For corners in Koylton Twp.

| | | |
|------------------------------------|-------------------------------------|---------------|
| <u>Tuscola</u> (County) | Located In: | Corner Code # |
| 1. Public Land Survey | <u>T11N R11E</u> | <u>A-5</u> ✓ |
| | T <u> </u> R <u> </u> | |
| | <u>T11N R10E</u> | <u>M-5</u> |
| | T <u> </u> R <u> </u> | |
| 2. Property Controlling in Section | S <u> </u> T <u> </u> R <u> </u> | |
| | S <u> </u> T <u> </u> R <u> </u> | |
| 3. Miscellaneous Property in Sec. | S <u> </u> T <u> </u> R <u> </u> | |
| | S <u> </u> T <u> </u> R <u> </u> | |

Register of Deeds Stamp & File Number

4. Lot No. _____, Recorded Plat _____
 5. Private Claims _____

I, Kenneth D. Dunton in a field survey on May 19, 1996 do hereby state that under requirements of P.A. 74, Michigan P.A. of 1970, the corner points mentioned in lines 1 and 2 above were in conformance with regulations and rules therefore as required in the current manual of survey instructions of the United States Department of the Interior, Bureau of Land Management or by a decree of a Court of Law and/or that the corner points mentioned in lines 3, 4 and 5 above were in conformance with the rules of the Michigan Board of Land Surveyors or by a Decree of a Court of Law, established, re-established, monumented, recovered, found as expressed below:

NOTE: Not more than 2 corners, all in the same town and range, may be recorded on this certificate.

| A | B | C | D | E | F | G | H | I | J | K | L | M |
|----|----|---|----|---|----|---|----|---|----|---|----|---|
| 1 | | | | | | | | | | | | |
| 2 | 6 | | 5 | | 4 | | 3 | | 2 | | 1 | |
| 3 | | | | | | | | | | | | |
| 4 | 7 | | 8 | | 9 | | 10 | | 11 | | 12 | |
| 5 | | | | | | | | | | | | |
| 6 | 18 | | 17 | | 16 | | 15 | | 14 | | 13 | |
| 7 | | | | | | | | | | | | |
| 8 | 19 | | 20 | | 21 | | 22 | | 23 | | 24 | |
| 9 | | | | | | | | | | | | |
| 10 | 30 | | 29 | | 28 | | 27 | | 26 | | 25 | |
| 11 | | | | | | | | | | | | |
| 12 | 31 | | 32 | | 33 | | 34 | | 35 | | 36 | |
| 13 | | | | | | | | | | | | |

A. Description of original monument and accessories and/or subsequent restoration:

| | |
|-----------------------------|--|
| GLO 1834 | Date of survey unknown. |
| Harvey Parke, D.S. | Edward Teskey, County Surveyor 1895-1898 |
| Set post cor. Secs. 12 & 13 | Section 7, T11N-R11E |
| Hemlock 28 S 37 W 44 1/2 | Stake at 0 |
| Hemlock 18 N 4 W 8 | Maple S45E 55 |
| Corner M-5, T11N-R10E | School house SW 1.43 |

Note: Section A continued on back of form.

B. Description of corner evidence found and/or method applied in restoring or reestablishing corner:

Found 1/2" rod in 1" pipe. Held as the best evidence of the original corner.

C. Description of monument for corner and accessories established to perpetuate locating the position of the corner:


Removed 1/2" rod & 1" pipe and placed standard monument stamped M-5, T11N-R10E.
 S45°E 62.24' set T.C. Remon. tag & spike in S. face 10" Pine.
 N22°W 23.31' set T.C. Remon. tag & spike in E. face 24" Maple.
 N64°E 46.49' set T.C. Remon. tag & spike in NW face T. pole (new).
 S42°E 70.37' fnd. 11192 tag & nail in NW face P. pole.
 S37°E 38.80' set T.C. Remon. tag & spike in SW face 24" Maple.

Note: This corner is common with M-5, T11N-R10E.

Signed by [Signature]
 Surveyor's Michigan License No. 23503

Date 11-11-96

APPROVED
11-11-96
[Signature]

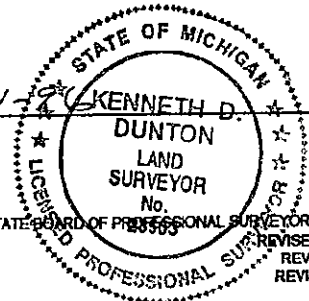

FORM APPROVED BY MICHIGAN STATE BOARD OF PROFESSIONAL SURVEYORS, JAN. 28, 1971
 REVISED MAY 14, 1975
 REVISED JAN., 1983
 REVISED OCT., 1995

REMONUMENT
 MAY 26 1997
 COMMANDER

209

May, 1973

L.C.R.C. filed by David T. Rowe, Land Surveyor #11192, Page 22, Dayton Twp. Found nothing from excavation. Set 1" pipe 30" long from survey Liber 1, P-38 and occupation of road East & West.

- N75°E 45.85' RLS 11192 tag in T.P.
- S45°E 70.35' RLS 11192 tag in P.P.
- S20°E 73.55' RLS 11192 tag in 24" Maple.

June 27, 1973

Survey by David T. Rowe, Land Surveyor #11192, Liber 436-Pages 267 & 268. 1" pipe. Same accessories as L.C.R.C. page 22.

Jan. 15, 1975

Survey by Robert G. Kay, Land Surveyor #14096, Liber 447, Pages 230 & 231. No mention of object found or set or accessories.

Aug. 18, 1980

Survey by Earl E. Gravlin, Land Surveyor #23510, Liber 508, Page 1092 & 1093. No mention of object found.

- N75°E 45.85' nail T.P.
- S45°E 70.35' nail P.P.
- S20°E 73.55' nail 24" Maple.
- N10°W 47.38' nail 24" Maple.

Oct. 5, 1984

Survey by Earl E. Gravlin, Land Surveyor #23510, Liber 545-Page 1292.

- Fnd. 1" pipe.
- N40°W 23.25' 24" Maple.
- N50°E 46.14' T.P.
- S45°E 38.89' 24" Maple.

July 22, 1993

Earl E. Gravlin, Land Surveyor #23510 unrecorded survey job #93641. No mention of object found or set or accessories.

