

**1996 REMONUMENTATION PROGRAM
LAND CORNER RECORDATION CERTIFICATE
Filing Requirement of Act 74, Mich. P.A. 1970**

For corners in Koylton Twp.

Tuscola Located In: _____ Corner Code # _____
(County)

1. Public Land Survey T11NR 11E A-7
T ___ R ___
T11N R10E M-7
T ___ R ___
2. Property Controlling S ___ T ___ R ___
in Section S ___ T ___ R ___
3. Miscellaneous S ___ T ___ R ___
Property in Sec. S ___ T ___ R ___

RECEIVED FOR RECORD
LIBER NO. _____ PAGE NO. 218
FILE NO. Koylton
96 DEC 10 PM 4:48
TUSCOLA COUNTY
REGISTER OF DEEDS
Register of Deeds Stamp & File Number

4. Lot No. _____, Recorded Plat _____
5. Private Claims _____

	A	B	C	D	E	F	G	H	I	J	K	L	M
1													
2	6		5		4		3		2		1		
3													
4	7		8		9		10		11		12		
5													
6	18		17		16		15		14		13		
7													
8	19		20		21		22		23		24		
9													
10	30		29		28		27		26		25		
11													
12	31		32		33		34		35		36		
13													

I, Kenneth D. Dunton in a field survey on May 19, 1996 do hereby state that under requirements of P.A. 74, Michigan P.A. of 1970, the corner points mentioned in lines 1 and 2 above were in conformance with regulations and rules therefore as required in the current manual of survey instructions of the United States Department of the Interior, Bureau of Land Management or by a decree of a Court of Law and/or that the corner points mentioned in lines 3, 4 and 5 above were in conformance with the rules of the Michigan Board of Land Surveyors or by a Decree of a Court of Law; established, re-established, monumented, recovered, found as expressed below:

NOTE: Not more than 2 corners, all in the same town and range, may be recorded on this certificate.

A. Description of original monument and accessories and/or subsequent restoration:
GLO 1834 Mar. 27, 1891
Harvey Parke, D.S. G.B. Felton, County Surveyor
Set post corner Secs. 13 & 14 Section 24 T11N-R10E
Birch 24 N17 1/1 W43 Previously established from
Hemlock 9 S 25 W 20 B.T.'s
Corner M-7, T11N-R10E Sugar 6 S84 1/2 W S30
Cedar post, glass & crockery cor.
Note: Section A continued on back of form.

B. Description of corner evidence found and/or method applied in restoring or reestablishing corner:
Found 1/2" rod (bent). Held as the best evidence of the original corner.


REMONUMENTATION
MAY 20 1997
COMMISSION

C. Description of monument for corner and accessories established to perpetuate locating the position of the corner:
Removed 1/2" rod and placed standard monument stamped M-7, T11N-R10E.
S57°W 37.12' chiseled notch atop S. end 40' of 15" CSP.
N43°E 60.74' set T. C. Remon. tag & spike in NW face P. pole.
S70°E 57.49' set T. C. Remon. tag & spike in SW face 14" Pine.
N88°E 32.80' fnd. 1/4" rod & cap #1__96.

Note: This corner is common with M-7, T11N-R10E.

Signed by [Signature]
Surveyor's Michigan License No. 23503

Date 11-11-96

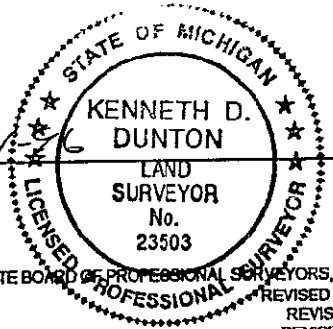

APPROVED
11-11-96
[Signature]

May, 1973

L.C.R.C. form filed by David T. Rowe, Land Surveyor #11192, Page 20, Dayton Twp
Fnd. 1/2" re-rod.

- N40°E 64.43' RLS 11192 tag in P.P.
- S70°W 86.67' RLS 11192 tag in 30" Maple.
- S55°W 37.10' "X" in road sign post.

June 21, 1973

Survey by David T. Rowe, Land Surveyor #11192, Liber 433-Pages 134 & 135
Fnd. 1/2" re-rod
Same accessories as L.C.R.C. Page 20.

Jan. 15, 1975

Survey by Robert G. Kay, Land Surveyor #14096, Liber 447-Pages 230 & 231.
1/2" iron.
N50°E 60.58' nail P.P.
S70°W 88.03' nail 26" Maple.
S60°W 39.93' road sign.

Feb. 17, 1976

Survey by Robert G. Kay, Land Surveyor #14096, Liber 457-Page 944
Same object and accessories as L-447, P-230 & 231.

Oct. 5, 1984

Survey by Earl E. Gravlin, Land Surveyor #23510, Liber 545-Page 1292
Fnd. 1/2" iron
Same accessories as L-457, P-944

Dec. 9, 1988

L.C.R.C. form filed by Ray D. Davis, Land Surveyor #22430
Fnd. 1/2" iron using local recorded surveys and corner records.
N40°E 64.43' tag in P. pole.
S55°W 37.10' crossroad sign.
S70°W 86.67' tag in 30" Maple.
North 5.65' 1/2" iron.

