

**1996 REMONUMENTATION PROGRAM
LAND CORNER RECORDATION CERTIFICATE
Filing Requirement of Act 74, Mich. P.A. 1970**

For corners in Koylton Twp.

<u>Tuscola</u> (County)	Located In:	Corner Code #
1. Public Land Survey	T <u>11N</u> R <u>11E</u>	<u>A-10</u> ✓
	T <u> </u> R <u> </u>	
	T <u>11N</u> R <u>10E</u>	<u>M-10</u>
	T <u> </u> R <u> </u>	
2. Property Controlling in Section	S <u> </u> T <u> </u> R <u> </u>	
	S <u> </u> T <u> </u> R <u> </u>	
3. Miscellaneous Property in Sec.	S <u> </u> T <u> </u> R <u> </u>	
	S <u> </u> T <u> </u> R <u> </u>	

RECEIVED FOR RECORD
LIBER NO. _____ PAGE NO. 51
FILE NO. Koylton
96 DEC 10 PM 4:48
Joseph W. Brown
TUSCOLA COUNTY
REGISTER OF DEEDS

Register of Deeds Stamp & File Number

4. Lot No. _____, Recorded Plat _____
5. Private Claims _____

I, Kenneth D. Dunton in a field survey on May 18, 1996 do hereby state that under requirements of P.A. 74, Michigan P.A. of 1970, the corner points mentioned in lines 1 and 2 above were in conformance with regulations and rules therefore as required in the current manual of survey instructions of the United States Department of the Interior, Bureau of Land Management or by a decree of a Court of Law and /or that the corner points mentioned in lines 3, 4 and 5 above were in conformance with the rules of the Michigan Board of Land Surveyors or by a Decree of a Court of Law; established, re-established, monumented, recovered, found as expressed below:

1	A	B	C	D	E	F	G	H	I	J	K	L	M
2		6		5		4		3		2		1	
3													
4		7		8		9		10		11		12	
5													
6		18		17		16		15		14		13	
7													
8		19		20		21		22		23		24	
9													
10		30		29		28		27		26		25	
11													
12		31		32		33		34		35		36	
13													

NOTE: Not more than 2 corners, all in the same town and range, may be recorded on this certificate.

A. Description of original monument and accessories and/or subsequent restoration:

G.L.O. 1834
Harvey Parke, D.S.
Set Quarter Section Post
Cedar 6 N29W 10
Hemlock 28 S52W 17
Corner M-10, T11N-R10E.

REMONUMENTATION
MAY 29 1997
COMMISSION

B. Description of corner evidence found and/or method applied in restoring or reestablishing corner:

Found 1/2" rod in centerline road between occupied fences E & W. Held rod as best evidence of original corner.

C. Description of monument for corner and accessories established to perpetuate locating the position of the corner:


Removed 1/2" rod & placed standard monument stamped corner M-10, T11N-R10E.
S65°W 31.56' set T. C. Remon. tag & spike in SE face 15" Ash.
West 44.37' set T. C. Remon. tag & spike in N. face Cedar.
East 21.64' set T. C. Remon. tag & spike in N. face new cor. post.
S55°E 25.23' set T. C. Remon. tag & spike in SW face fence post.

Note: This corner is common with M-10, T11N-R10E.

Signed by *Kenneth D. Dunton*
Surveyor's Michigan License No. 23503

Date 11-11-96

APPROVED
11-11-96
R.P.C.
R.L.B.
J.M.

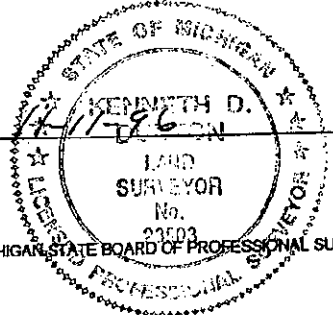

North

Section 25, T11N-R10E

Section 30, T11N-R11E

