

SURVEY & REMONUMENTATION

COPY

RECEIVED FOR RECORD
LIBER NO. ... PAGE NO. ...
FILING NO. #20
9th AUG 19 AM 11:12

OCT 26 1994

1994 REMONUMENTATION PROGRAM
LAND CORNER RECORDATION CERTIFICATE
Filing Requirement of Act 74, Mich. P.A. 1970

VIRGINIA H. MCLAREN
TUSCOLA COUNTY
REGISTER OF DEEDS

COMMISSION
For corners in Koylton Township

TUSCOLA (County) Located In: Corner Code: #7

1. Public Land Survey	T 11N R 11E	D-13
	T _____ R _____	
	T _____ R _____	
	T _____ R _____	
2. Property Controlling in Section	S _____ T _____ R _____	
	S _____ T _____ R _____	
3. Miscellaneous Property in Sec.	S _____ T _____ R _____	
	S _____ T _____ R _____	

Register of Deeds Stamp & File Number

4. Lot No. _____, Recorded Plat _____
5. Private Claims _____

	A	B	C	D	E	F	G	H	I	J	K	L
2	6	5	4	3	2							
3												
4	7	8	9	10	11	12						
5												
6	18	17	16	15	14	13						
7												
8	19	20	21	22	23	24						
9												
10	30	29	28	27	26	25						
11												
12	31	32	33	34	35	36						
13												

I, Kenneth D. Dunton in a field survey on May 1, 19 94, do hereby certify that under requirements of P.A. 74, Michigan P.A. of 1970, the corner points mentioned in lines 1 and 2 above were in conformance with regulations and rules therefore as required in the current manual of survey instructions of the United States Department of the Interior, Bureau of Land Management or by a decree of a Court of Law and/or that the corner points mentioned in lines 3, 4 and 5 above were in conformance with the rules of the Michigan Board of Land Surveyors or by a Decree of a Court of Law; established, re-established, monumented, re-monumented, recovered, found as expressed below:

NOTE: Not more than 4 corners, all in the same town and range, may be recorded on this certificate.

A. Description of original monument and accessories and/or subsequent restoration:

1834 G.L.O. Notes	July 13, 1891	April 10, 1990
Harvey Parke, D.S.	G. B. Felton, Co. Surveyor	Earl E. Gravelin, L.S. #23
Set 1/4 section post	From bearing trees	Survey Liber 615, Page 700
Cedar 11" N40°W 20 links	cedar post & plow	Set iron on occ. fence to North.
Cedar 14" N52°E 22 links	coulter at corner	N45°W 36.67' 18" elm
	No new witnesses	S60°E 76.34' p. pole
		N55°W 43.93' 10" aspen

Section A continued on back of this form:

B. Description of corner evidence found and/or method applied in restoring or reestablishing corner:

Found 1/2" rod set by Gravelin in 1990. Measured and proportioned mile to Felton 1891 resurvey. Dug 4' x 4' hole 30" deep at proportionate location, found no evidence of cedar post or plow coulter. Proportionate location falls within 2' of 1/2" rod found. Accepted 1/2" rod as best evidence of corner D-13.


C. Description of monument for corner and accessories established to perpetuate locating the position of the corner:

Removed 1/2" rod and set 36" concrete monument with standard brass cap stamped corner D-13, T11N-R11E.
S70°18'E 76.30' set remon. tag & spike in NE face p. pole.
N59°11'W 43.99' fnd. spike in SW face 10" stump.
N42°41'W 52.83' set remon. tag & spike in SW face 8" maple.
N39°48'W 36.71' fnd. spike in SW face 12" dead tree.
N01°51'W 42.95' fnd. #11192 tag & nail in E. face 8" maple of maple clump.
North 33.01' fnd. 1/2" rod & cap # 33134.

Signed by [Signature] Date Aug. 1, 1994

Surveyor's Michigan License No. 23503
[Signature]
APPROVED
8-1-94

FORM APPROVED BY MICHIGAN STATE BOARD OF LAND SURVEYORS, JAN 28, 1993
REVISED MAY 1, 1975
REVISED JAN 1, 1993

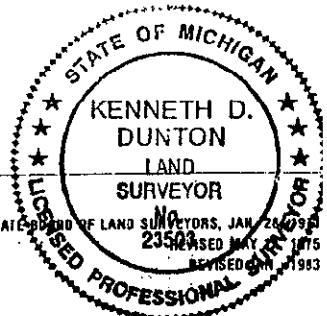

Section A continued.

Jan. 19, 1993 Survey Liber 640 on Pages 992 & 993 by Jonathan M. Field, L.S. #37276.
Found 1/2 rod.

S70°E 76.53' fnd. nail w/flag N. face p. pole.

N35°W 36.71' fnd. nail w/flag SW face 12" elm.

N55°W 43.95' fnd. nail w/flag SW face 10" stump.

N01°W 42.93' set nail w/tag #11192 E. face 10" maple.

