

OCT 20 1994

1994 REMONUMENTATION PROGRAM
LAND CORNER RECORDATION CERTIFICATE
Filing Requirement of Act 74, Mich. P.A. 1970

COMMISSION

For corners in Koylton Township

TUSCOLA

(County)

Located In:

Corner Code F-13

- 1. Public Land Survey T 11N R 11E F-13
- T _____ R _____
- T _____ R _____
- T _____ R _____
- 2. Property Controlling S _____ T _____ R _____
- in Section S _____ T _____ R _____
- 3. Miscellaneous S _____ T _____ R _____
- Property in Sec. S _____ T _____ R _____
- 4. Lot No. _____, Recorded Plat _____
- 5. Private Claims _____

RECEIVED FOR RECORD
LIBRARY - PAGE NO. _____
FILING NO. # 22
Koylton
94 AUG 19 AM 11:12
VIRGINIA H. McLAUGHLIN
TUSCOLA COUNTY
REGISTER OF DEEDS

Register of Deeds Stamp & File Number

	A	B	C	D	E	F	G	H	I	J	K	L	M
2	6		5		4		3		2		1		
3													
4	7		8		9		10		11		12		
5													
6	18		17		16		15		14		13		
7													
8	19		20		21		22		23		24		
9													
10	30		29		28		27		26		25		
11													
12	31		32		33		34		35		36		
13													

I, Kenneth D. Dunton in a field survey on May 21, 1994, do hereby certify that under requirements of P.A. 74, Michigan P.A. of 1970, the corner points mentioned in lines 1 and 2 above were in conformance with regulations and rules therefore as required in the current manual of survey instructions of the United States Department of the Interior, Bureau of Land Management or by a decree of a Court of Law and/or that the corner points mentioned in lines 3, 4 and 5 above were in conformance with the rules of the Michigan Board of Land Surveyors or by a Decree of a Court of Law; established, re-established, monumented, re-monumented, recovered, found as expressed below:

NOTE: Not more than 4 corners, all in the same town and range, may be recorded on this certificate.

A. Description of original monument and accessories and/or subsequent restoration:

1834 G.L.O. Notes	1957-59 M.S.H.D. road plans
Harvey Parke, D.S.	Proj. No. 44081 & 74041, sheet 7.
Set 1/4 section post	Sta. 215+42.43. 1" pipe
Sugar 22" N69°E 29 links	N70°E 74.23' tele. pole.
Sugar 14" N83°W 14 links	S16°E 82.55' 18" apple.
	S55°W 86.01' p.p.

Witness Card

No Date
Delamater-Muschell
Eng. & Land Surveying
Cheboygan, MI
same witnesses and object
as 57-59 M.D.O.T. plans

Section A continued on back of this form:

B. Description of corner evidence found and/or method applied in restoring or reestablishing corner:

Found boat spike in monument box and accepted as the best evidence of the original corner.

C. Description of monument for corner and accessories established to perpetuate locating the position of the corner:

Removed boat spike and replaced with 18" x 5/8" rod and 2" standard brass cap in concrete. Stamped cap F-13, T11N-R11E.
N52°23'W 28.16' set 1/2" rod & cap #23503 in road shoulder.
N52°52'E 29.46' set 1/2" rod & cap #23503 in road shoulder.
N02°32'W 29.55' found nail in W. face 12" wood post - set T.C. Remon. tag & spike over nail.
S52°05'E 75.55' found nail in NE face 13" twin apple - set T. C. Remon. tag & spike over nail.
S52°10'W 86.00' found PK nail & 2" disk in SE face p. pole. Also found M.S.H.D. tag in NW face at 85.89'.


Signed by [Signature]

Date Aug. 1, 1994

Surveyor's Michigan License No. 23503

APPROVED

8-1-94

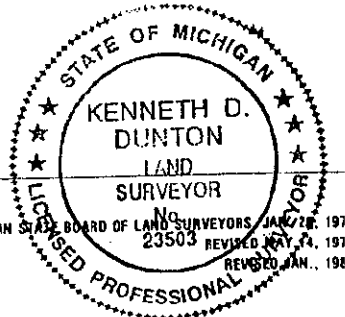

COPY

Section A continued:

Oct. 15, 1976 Robt. G. Kay, L.S. #14096. Survey Liber 466 on Page 593, found iron in mon. box.
North 29.19' nail in cor. post.
S60°E 75.50' nail in 10" apple.
S50°W 85.88' nail in p. p.

May 19, 1982 Lapeer County Road Commission, Marlette Road corner witnesses, sheet 1 of 4. Found boat spike in monument box.
S55°W 85.80' set p.k. w/flasher in D. E. pole.
Due North 29.34' existing nail w/ribbon in fence corner post.
S45°E 75.46' existing nail w/ribbon in 9" apple.

