

OCT 20 1994

COMMISSION

1994 REMONUMENTATION PROGRAM  
LAND CORNER RECORDATION CERTIFICATE  
Filing Requirement of Act 74, Mich. P.A. 1970

For corners in Koylton Township

TUSCOLA (County)

Located In:

Corner Code: #

- 1. Public Land Survey T 11N R 11E H-13
- 2. Property Controlling in Section S T R
- 3. Miscellaneous Property in Sec. S T R
- 4. Lot No. , Recorded Plat
- 5. Private Claims

RECEIVED FOR RECORD  
LIBER NO. PAGE NO.  
FILING NO. # 24  
Koylton  
94 AUG 19 AM 11:12  
VIRGINIA H. MELAREN  
TUSCOLA COUNTY  
REGISTER OF DEEDS

Register of Deeds Stamp & File Number

I, Kenneth D. Dunton, in a field survey on May 21, 19 94, do hereby certify that under requirements of P.A. 74, Michigan P.A. of 1970, the corner points mentioned in lines 1 and 2 above were in conformance with regulations and rules therefore as required in the current manual of survey instructions of the United States Department of the Interior, Bureau of Land Management or by a decree of a Court of Law and/or that the corner points mentioned in lines 3, 4 and 5 above were in conformance with the rules of the Michigan Board of Land Surveyors or by a Decree of a Court of Law; established, re-established, monumented, re-monumented, recovered, found as expressed below:

A	B	C	D	E	F	G	H	I	J	K	L	M
2	6		5		4		3		2			
3												
4	7		6		9		10		11		12	
5												
6	18		17		16		15		14		13	
7												
8	19		20		21		22		23		24	
9												
10	30		29		28		27		26		25	
11												
12	31		32		33		34		35		36	
13												

NOTE: Not more than 4 corners, all in the same town and range, may be recorded on this certificate.

A. Description of original monument and accessories and/or subsequent restoration:

1834 G.L.O. Notes  
Harvey Parke, D.S.  
Set 1/4 section post  
Birch 6" N74°W 20 links  
Maple 8" N59°E 30 links

1957-59 M.S.H.D. road plans  
Proj. No. 44081 & 74041, sheet 9.  
Sta. 268+37.33. 3/4" pipe  
N52°W 47.43' tele. pole  
N32°E 24.68' "+" in conc. hdwl.

Witness Card  
No date  
Delamater-Muschell  
Engr. & Land Surveyors  
Cheboygan, MI  
Same witnesses and  
object as 57-59 M.S.H.I  
plans

Section A continued on back of this form:

B. Description of corner evidence found and/or method applied in restoring or reestablishing corner:

Found boat spike in monument box & accepted as the proper position of the original corner.

C. Description of monument for corner and accessories established to perpetuate locating the position of the corner:

Removed boat spike and replaced with 18" x 5/8" rod & 2" standard brass cap in concrete.  
Stamped cap corner H-13, T11N-R11E.  
N29°35'W 41.90' fnd. p.k. nail in N. end conc. headwall.  
N24°04'W 53.61' fnd. p.k. nail & 2" disc in SW face tele. pole stub.  
N22°52'E 37.76' fnd. p.k. nail in N. end conc. headwall.  
N28°46'E 31.06' SE corner conc. headwall.  
N61°00'E 51.70' fnd. "+" atop center of conc. headwall Sta. 268+82.  
S68°54'E 130.80' set T.C. Remon. tag & spike in NE face p. pole.  
S50°17'W 72.53' found p.k. nail & 2" disc in SE face of p. pole.


Signed by Kenneth D. Dunton

Date Aug. 1, 1994

Surveyor's Michigan License No. 23503

APPROVED

2-1-94

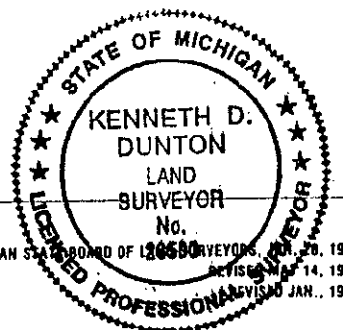

COPY

Section A continued:

Aug. 27, 1989 Act 74 form filed with Tuscola County Register of Deeds 8-6-1991 by Earl Gravelin, L.S. #23510. Found monument box (no mention of object in box)  
S65°W 53.45' tele. ped. wood post.  
N60°E 30.98' SE cor. conc. headwall.  
S50°W 72.50' power pole.

