

OCT 26 1994

COMMISSION

1994 REMONUMENTATION PROGRAM LAND CORNER RECORDATION CERTIFICATE Filing Requirement of Act 74, Mich. P.A. 1970

For corners in Koylton Township

<u>TUSCOLA</u> <small>(County)</small>	Located In:	Corner Code <u>J-13</u>
1. Public Land Survey	T <u>11N</u> R <u>11E</u>	
	T _____ R _____	
	T _____ R _____	
	T _____ R _____	
2. Property Controlling in Section	S _____ T _____ R _____	
	S _____ T _____ R _____	
3. Miscellaneous Property in Sec.	S _____ T _____ R _____	
4. Lot No. _____, Recorded Plat _____		
5. Private Claims _____		

RECEIVED FOR RECORD
LIBER NO. _____ PAGE NO. _____
FILING NO. 426
KOYLTON
94 AUG 19 AM 11:13
VIRGINIA M. HOLLAND
TUSCOLA COUNTY
REGISTER OF DEEDS
Register of Deeds Stamp & File Number

A	B	C	D	E	F	G	H	I	J	K	L	M
2	6	5	4	3	2							
3												
4	7	8	9	10	11	12						
5												
6	18	17	16	15	14	13						
7												
8	19	20	21	22	23	24						
9												
10	30	29	28	27	26	25						
11												
12	31	32	33	34	35	36						
13												

I, Kenneth D. Dunton, in a field survey on May 21, 19 94, do hereby certify that under requirements of P.A. 74, Michigan P.A. of 1970, the corner points mentioned in lines 1 and 2 above were in conformance with regulations and rules therefore as required in the current manual of survey instructions of the United States Department of the Interior, Bureau of Land Management or by a decree of a Court of Law and/or that the corner points mentioned in lines 3, 4 and 5 above were in conformance with the rules of the Michigan Board of Land Surveyors or by a Decree of a Court of Law; established, re-established, monumented, re-monumented, recovered, found as expressed below:

NOTE: Not more than 4 corners, all in the same town and range, may be recorded on this certificate.

A. Description of original monument and accessories and/or subsequent restoration:

1834 G.L.O. Notes	1957-59 M.S.H.D. road plans	Witness card
Harvey Parke, D.S.	Proj. No. 44081 & 74041 sheet 11.	Date unknown
Set 1/4 Section Post	Sta. 321+28.17. 1" pipe.	Delamater-Muschell
Maple 12" N49°W 30 links	N01°W 54.52' 6" ash.	Eng. & Land Surveyors
Hemlock ?" N87°E 7½ links	S54°W 50.62' 14" maple.	Cheboygan, MI
	S44°E 97.17' power pole.	Witnesses same as
		57-59 M.S.H.D. plans

Section A continued on back of this form.

B. Description of corner evidence found and/or method applied in restoring or reestablishing corner:
Found boat spike in monument box and accepted as the best evidence of the original corner.


C. Description of monument for corner and accessories established to perpetuate locating the position of the corner:
Removed boat spike and replaced with 18" x 5/8" rod & 2" standard brass cap in concrete. Stamped cap corner J-13, T11N-R11E.
N41°39'W 41.40' found 1/2" rod at top of ditch bank.
S36°50'W 36.54' found 1/2" rod at top of ditch bank.
N38°17'E 21.72' set 1/2" rod & cap #23503 in road shoulder.
S45°38'E 97.18' found M.S.H.D. tag & nail in W. face p. pole. Also found p.k. nail & 2" disc in W. face at 97.08'.
N02°25'W 36.46' found nail atop 6" wood post.

Signed by [Signature]

Date Aug. 1, 1994

Surveyor's Michigan License No. 23503

[Signature]
APPROVED
8-1-94

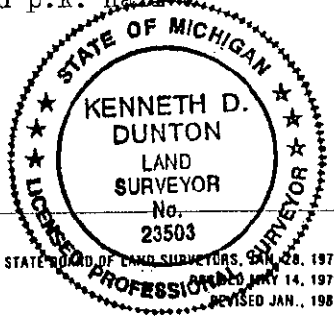

COPY

Section A continued:

May 19, 1982 Lapeer County Road Commission, Marlette Road corner witnesses, sheet 3 of 4.


Found boat spike in mon. box.

S40°E 96.97' set p.k. w/flasher in D.E. pole.

N05°W 36.29' existing nail in top of post.

N45°W 41.44' set 1/2" iron at top of backslope.

S45°W 36.56' set 1/2" iron at top of backslope.

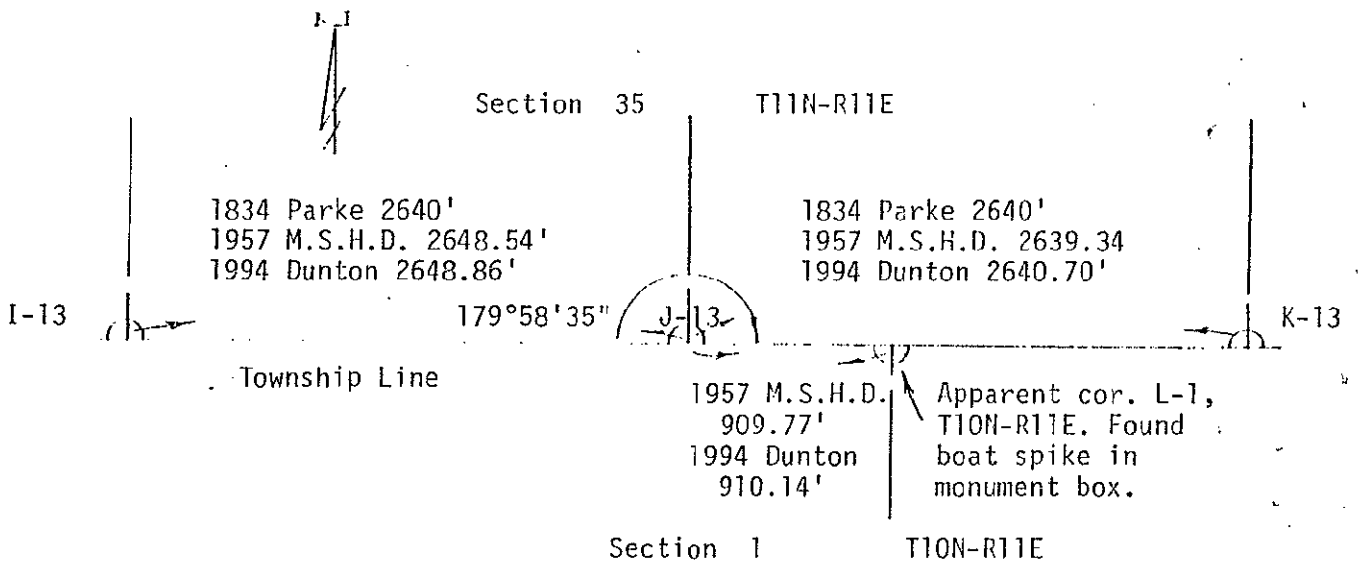

