

OCT 20 1994

1994 REMONUMENTATION PROGRAM  
LAND CORNER RECORDATION CERTIFICATE  
Filing Requirement of Act 74, Mich. P.A. 1970

COMMISSION

For corners in Koylton Township

RECEIVED FOR RECORD  
LIBER NO. PAGE NO.  
FILING NO. #27  
Koylton  
94 AUG 19 AM 11:13  
VIRGINIA H. MCLAREN  
TUSCOLOA COUNTY  
REGISTER OF DEEDS

Register of Deeds Stamp & File Number

TUSCOLOA (County) Located In: Corner Code #/

|                                    |             |      |
|------------------------------------|-------------|------|
| 1. Public Land Survey              | T 11N R 11E | K-13 |
|                                    | T R         |      |
|                                    | T R         |      |
|                                    | T R         |      |
| 2. Property Controlling in Section | S T R       |      |
|                                    | S T R       |      |
| 3. Miscellaneous Property in Sec.  | S T R       |      |
|                                    | S T R       |      |

4. Lot No. \_\_\_\_\_, Recorded Plat \_\_\_\_\_

5. Private Claims \_\_\_\_\_

| A  | B  | C  | D  | E  | F  | G  | H | I | J | K | L | M |
|----|----|----|----|----|----|----|---|---|---|---|---|---|
| 2  | 6  | 5  | 4  | 3  | 2  | 1  |   |   |   |   |   |   |
| 3  |    |    |    |    |    |    |   |   |   |   |   |   |
| 4  | 7  | 8  | 9  | 10 | 11 | 12 |   |   |   |   |   |   |
| 5  |    |    |    |    |    |    |   |   |   |   |   |   |
| 6  | 18 | 17 | 16 | 15 | 14 | 13 |   |   |   |   |   |   |
| 7  |    |    |    |    |    |    |   |   |   |   |   |   |
| 8  | 19 | 20 | 21 | 22 | 23 | 24 |   |   |   |   |   |   |
| 9  |    |    |    |    |    |    |   |   |   |   |   |   |
| 10 | 30 | 29 | 28 | 27 | 26 | 25 |   |   |   |   |   |   |
| 11 |    |    |    |    |    |    |   |   |   |   |   |   |
| 12 | 31 | 32 | 33 | 34 | 35 | 36 |   |   |   |   |   |   |
| 13 |    |    |    |    |    |    |   |   |   |   |   |   |

I, Kenneth D. Dunton, in a field survey on May 28, 19 94, do hereby certify that under requirements of P.A. 74, Michigan P.A. of 1970, the corner points mentioned in lines 1 and 2 above were in conformance with regulations and rules therefore as required in the current manual of survey instructions of the United States Department of the Interior, Bureau of Land Management or by a decree of a Court of Law and/or that the corner points mentioned in lines 3, 4 and 5 above were in conformance with the rules of the Michigan Board of Land Surveyors or by a Decree of a Court of Law; established, re-established, monumented, re-monumented, recovered, found as expressed below:

NOTE: Not more than 4 corners, all in the same town and range, may be recorded on this certificate.

A. Description of original monument and accessories and/or subsequent restoration:

|                             |                             |                       |
|-----------------------------|-----------------------------|-----------------------|
| 1834 G.L.O. Notes           | 1957-59 M.S.H.D. road plans | Witness card          |
| Harvey Parke, D.S.          | Project No. 44081 & 74041   | Date unknown          |
| Set post corner             | Sheet 12. Sta. 347+67.41.   | Delamater-Muschell    |
| Sections 35 & 36            | 3/4" pipe.                  | Eng. & Land Surveyors |
| Beech 8" N68 1/2°E 16 links | N19°W 60.58' 22" elm.       | Cheboygan, MI         |
| Beech 8" N36°W 27 links     | S73°W 104.20' 20" elm.      | Witness same as 57-59 |
|                             | S31°E 102.79' power pole    | M.S.H.D. plans.       |

Section A continued on back of this form:

B. Description of corner evidence found and/or method applied in restoring or reestablishing corner:

Found boat spike in monument box & accepted as the best evidence of the original corner.

C. Description of monument for corner and accessories established to perpetuate locating the position of the corner:

Removed boat spike & replaced with 18" x 5/8" rod & 2" standard brass cap in concrete.  
 Stamped cap corner K-13, T11N-R11E.  
 N37°28'E 54.97' found p.k. nail & 2" disc in NW face t. pole guy.  
 S59°34'E 52.37' found "+" atop center of conc. headwall Sta. 348+13.  
 S45°23'E 46.55' set T. C. Remon. tag & spike in NE face t. pole.  
 S32°46'E 102.86' found M.S.H.D. tag in N. face p. pole - set T. C. Remon. tag & spike in N. face 3' above M.S.H.D. tag.  
 S13°41'E 23.68' W. leg of arrow road sign.


Signed by [Signature]

Date Aug. 1, 1994

Surveyor's Michigan License No. 23503

APPROVED

8-1-94

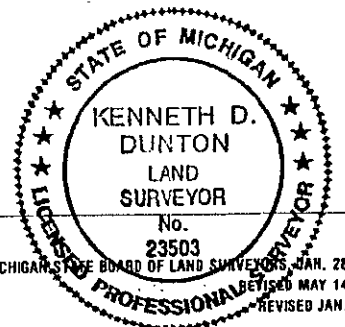

# COPY

Section A continued:

Sept. 21, 1978 Survey Liber 491, Page 823 by Robt. G. Kay, L.S. #14096. No mention of object found or set.

N45°E 45.95' to t.p.

S40°E 46.50' to t.p.

S20°E 19.80' to West leg of road sign.

July 7, 1982 Lapeer County Road Commission

Marlette Road corner witnesses, sheet 4 of 4.

Found boat spike in mon. box.

N45°E 54.95' set p.k. w/flasher in bell pole.

S40°E 46.43' set p.k. w/flasher in bell pole.

S50°E 52.39' "+" on conc. headwall.

S50°W 31.71' chiseled "+" top of West end drive culvert.

Aug. 21, 1991 Unrecorded survey by Russell L. Brown, R.L.S. #24588. Project #91-96

Found boat spike in mon. box.

N45°E 55.00' p.k. nail in t.p.

S40°E 46.50' p.k. nail in t.p.

S20°E 23.19' W. leg of road sign.

