

COPY

REMONUMENTATION

DEC 07 1994

COMMISSION

1994 REMONUMENTATION PROGRAM
LAND CORNER RECORDATION CERTIFICATE
Filing Requirement of Act 74, Mich. P.A. 1970

For corners in KOYLTON TOWNSHIP

RECEIVED FOR RECORD
LIBER NO. _____ PAGE NO. _____
FILING NO. # 30
KOYLTON TOWNSHIP
54 NOV -9 PM 2: 20
VIRGINIA M. McLAUGHLIN
TUSCOLA COUNTY
REGISTER OF DEEDS

_____ TUSCOLA _____ (County)	Located In:	Corner Code #/
1. Public Land Survey	T 11N. R 11E	M-1
	T _____ R _____	_____
	T _____ R _____	_____
	T _____ R _____	_____
2. Property Controlling in Section	S _____ T _____ R _____	_____
	S _____ T _____ R _____	_____
3. Miscellaneous Property in Sec.	S _____ T _____ R _____	_____
	S _____ T _____ R _____	_____
4. Lot No. _____, Recorded Plat _____		
5. Private Claims _____		

Register of Deeds Stamp & File Number

I, Lionel Roy Emery, in a field survey on July 4, 19 94, do hereby certify that under requirements of P.A. 74, Michigan P.A. of 1970, the corner points mentioned in lines 1 and 2 above were in conformance with regulations and rules therefore as required in the current manual of survey instructions of the United States Department of the Interior, Bureau of Land Management or by a decree of a Court of Law and/or that the corner points mentioned in lines 3, 4 and 5 above were in conformance with the rules of the Michigan Board of Land Surveyors or by a Decree of a Court of Law; established, re-established, monumented, re-monumented, recovered, found as expressed below:

NOTE: Not more than 4 corners, all in the same town and range, may be recorded on this certificate.

	A	B	C	D	E	F	G	H	I	J	K	L	M
2	6		5		4		3		2		1		
3													
4	7		8		9		10		11		12		
5													
6	10		17		16		15		14		13		
7													
8	19		20		21		22		23		24		
9													
10	30		29		28		27		26		25		
11													
12	31		32		33		34		35		36		
13													

A. Description of original monument and accessories and/or subsequent restoration:

1834 (Gov't. Land Office Notes) Harvey Parke, D.S. -Set temporary Township corner at 80.00 chain Township corner established at 79.21 chains- Hemlock 15 North 7; Hemlock 28 S29W 8½; W. Ash 20 N6E 29; Hemlock 28 S29W 8½; Birch 17 S29W 41; Hemlock 28 S29W 21½

1882 (County Surveyor's Record) John A. Teskey, Tuscola County Surveyor -Established proportiona distance from identified corners and sight trees- Stake S45W 70 links; Stake N45W 70 links

1963 (Michigan State Highway Department witness card) Donald C. Pyle, P.S. 3165 - Found 1" Pipe buried 2' deep - S22°E 62.42' 29" Elm; N20°E 90.15' 26" Tw Elm; North 90.39 27" Tw Elm

1987 (Survey -Liber 578, pages 58 and 59) Kenneth D. Dunton, P.S. 23503 -Fnd 1" pipe in Mon. box North 1.0' center line of M-46; S20°W 56.3' S end of curb; S45°W 48.9' W end of curb

B. Description of corner evidence found and/or method applied in restoring or reestablishing corner:

Found 1" inside diameter Pipe in Monument Box together with Dunton's accessories.

Accepted Pipe as marking original Township corner. This corner is common to Townships 11 and 12 North of Range 11 East and Townships 11 and 12 North of Range 12 East.

C. Description of monument for corner and accessories established to perpetuate locating the position of the corner:


Placed 5/8" diameter by 12" long reinforcing rod with Tuscola County Standard 2" Brass cap affix inside found 1" Pipe. Stamped Cap M1 T11N /R11E and placed concrete inside Monument Box

N50°E, 46.29' set ½" diameter reinforcing rod
 S40°E, 48.28' set ½" diameter reinforcing rod 1 ft. behind back of concrete curb
 S50°W, 45.70' set ½" diameter reinforcing rod 1 ft. behind back of concrete curb
 N40°W, 44.63' set ½" diameter reinforcing rod

Signed by Lionel Roy Emery
Surveyor's Michigan License No. 24593

Date Aug. 31, 1994

APPROVED
E-31-94

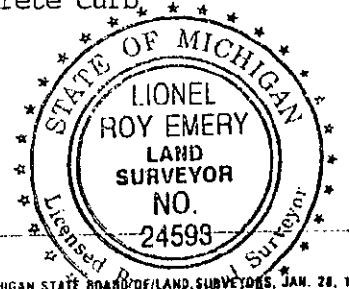

COPY

TUSCOLA COUNTY
KINGSTON TWP.
T12N-R1E



NO SCALE

TUSCOLA COUNTY
KOYLTON TWP.
T11N-R1E

N.E. 1/4 OF SECTION 1

S.E. 1/4 OF SECTION 36

MSHD PLAN 179°44'55"
EMERY 1994 179°45'01"
MICHIGAN STATE HIGHWAY

PARKE 1834 2587.86 FT.
TESKEY 1886 2584.56 FT.
PYLE 1963 2594.00 FT.
DUNTON 1987 2594.76 FT.
EMERY 1994 2594.71 FT.

PARKE 1834 2640 FT.
PYLE 1963 2623.92 FT.
EMERY 1994 2623.60 FT.

MARTON
ROAD

MC ALPINE ROAD

SANILAC COUNTY
LAMOTTE TWP.
T12N-R1E

M-46

SANILAC COUNTY
MARLETTE TWP.
T11N-R1E

M 2

M 12

ROAD

C. L.

(2/1/03)