

COPY

REMONUMENTATION

DEC 07 1994

1994 REMONUMENTATION PROGRAM
LAND CORNER RECORDATION CERTIFICATE
Filing Requirement of Act 74, Mich. P.A. 1970

COMMISSION

For corners in KOYLTON TOWNSHIP

RECEIVED FOR RECORD
LIBER NO. _____ PAGE NO. _____
FILING NO. #31
KOYLTON TWP.
96 NOV -9 PM 2:20
VIRGINIA H. MCLAREN
TUSCOLA COUNTY
REGISTER OF DEEDS

Register of Deeds Stamp & File Number

	TUSCOLA (County)	Located In:	Corner Code -#
1. Public Land Survey		T 11N. R 11E	M-2
		T _____ R _____	_____
		T _____ R _____	_____
		T _____ R _____	_____
2. Property Controlling in Section	S _____	T _____ R _____	_____
	S _____	T _____ R _____	_____
3. Miscellaneous Property in Sec.	S _____	T _____ R _____	_____
	S _____	T _____ R _____	_____
4. Lot No. _____, Recorded Plat _____			
5. Private Claims _____			

	A	B	C	D	E	F	G	H	I	J	K	L
2	6	5	4	3	2	1						
3												
4	7	8	9	10	11	12						
5												
6	18	17	16	15	14	13						
7												
8	19	20	21	22	23	24						
9												
10	30	29	28	27	26	25						
11												
12	31	32	33	34	35	36						
13												

I, Lionel Roy Emery, in a field survey on July 4, 1994, do hereby certify that under requirements of P.A. 74, Michigan P.A. of 1970, the corner points mentioned in lines 1 and 2 above were in conformance with regulations and rules therefore as required in the current manual of survey instructions of the United States Department of the Interior, Bureau of Land Management or by a decree of a Court of Law and/or that the corner points mentioned in lines 3, 4 and 5 above were in conformance with the rules of the Michigan Board of Land Surveyors or by a Decree of a Court of Law; established, re-established, monumented, re-monumented, recovered, found as expressed below:

NOTE: Not more than 4 corners, all in the same town and range, may be recorded on this certificate.


- A. Description of original monument and accessories and/or subsequent restoration:
- 1834 (Gov't. Land Office Notes) Harvey Parke, D.S. -Set quarter section post- Elm 10 S36 $\frac{1}{2}$ W 30; Elm 6 N49W 23
 - 1882 (County Surveyor's Record) John A. Teskey, Tuscola County Surveyor -"Established proportion distance between Sec corners" accessories: Stake East 50 links; Stake West 50 links
 - 1963 (Michigan State Highway Department witness card) Donald C. Pyle, P.S. 3165 -set 1" Pipe- S77°E 25.66' 27" Maple; S76°W 31.21' T.P.
 - 1987 (Survey -Liber 578, pages 58 and 59) Kenneth D. Dunton, P.S. 23503 -Fnd. 1" Pipe- S80°W 31.0' MSHD tag in post; S80°E 25.6' MSHD tag in 24" tree; East 2.5' center line N-S gravel

B. Description of corner evidence found and/or method applied in restoring or reestablishing corner:
Found 1" ^{Pipe} i.d., 16" long and accessories as indicated by Pyle. Also found extensive wood fibers at 24" +/- below gravel surface.

Accepted Pipe as marking original corner

- C. Description of monument for corner and accessories established to perpetuate locating the position of the corner:
- Removed Pipe and replaced with Standard Tuscola County Concrete Monument w/2" Brass cap stamped M2 T11N/R11E
 S75°E, 25.68'-T.C. Remon. tag over M.S.H.D. tag in Southwest face of 24" Maple
 S60°E, 56.95'-T.C. Remon. tag in Southwest face of 4" Elm
 S75°W, 31.06'-T.C. Remon. tag over M.S.H.D. tag in North face of Tele pole stub
 N08°W, 36.12'-Set 1/2" diameter reinforcing rod

Signed by Lionel Roy Emery Date Sep. 19, 1994
Surveyor's Michigan License No. 24593

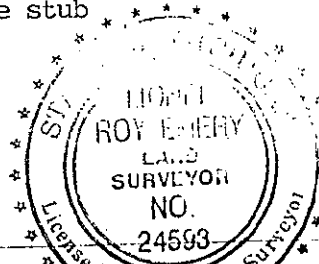

APPROVED
9-19-94

COPY

