

DEC 07 1994

COPY

COMMISSION

1994 REMONUMENTATION PROGRAM
LAND CORNER RECORDATION CERTIFICATE
Filing Requirement of Act 74, Mich. P.A. 1970

For corners in KOYLTON TOWNSHIP
TUSCOLA
(County)

Located In: Corner Code ##

- 1. Public Land Survey T 11N. R 11E. M-5
T _____ R _____
T _____ R _____
T _____ R _____
- 2. Property Controlling S _____ T _____ R _____
in Section S _____ T _____ R _____
- 3. Miscellaneous S _____ T _____ R _____
Property in Sec. S _____ T _____ R _____

RECEIVED FOR RECORD
LIBER NO. _____ PAGE NO. _____
FILING NO. 434
KOYLTON TWP
9/11 NOV -9 PM 2:20
VIRGINIA H. MCLAREN
TUSCOLA COUNTY
REGISTER OF DEEDS

Register of Deeds Stamp & File Number

- 4. Lot No. _____, Recorded Plat _____
- 5. Private Claims _____

A	B	C	D	E	F	G	H	I	J	K	L
2	6	5	4	3	2	1					
3											
4	7	8	9	10	11	12					
5											
6	18	17	16	15	14	13					
7											
8	19	20	21	22	23	24					
9											
10	30	29	28	27	26	25					
11											
12	31	32	33	34	35	36					
13											

I, Lionel Roy Emery, in a field survey on June 30, 1994, do hereby certify that under requirements of P.A. 74, Michigan P.A. of 1970, the corner points mentioned in lines 1 and 2 above were in conformance with regulations and rules therefore as required in the current manual of survey instructions of the United States Department of the Interior, Bureau of Land Management or by a decree of a Court of Law and/or that the corner points mentioned in lines 3, 4 and 5 above were in conformance with the rules of the Michigan Board of Land Surveyors or by a Decree of a Court of Law; established, re-established, monumented, re-monumented, recovered, found as expressed below:

NOTE: Not more than 4 corners, all in the same town and range, may be recorded on this certificate.

A. Description of original monument and accessories and/or subsequent restoration:

- 1834 (Gov't. Land Office Notes) Harvey Parke, D.S. -Set post Cor. Sections 12,13- Hemlock 24 N4 72½; Beech 8 S45W 27
- 1886 (County Surveyor's Record) John A. Teskey, Tuscola County Surveyor -marked corner with stone No Bearing trees
- 1973 (Survey -Liber 431, page 387) Harold N. Elrich, P.S. 18986 -Found nail using "ties" and set ½" iron- N60°E 51.0' Sign Post; S30°W 44.0' Fence Post; S60°W 42.43' U.S.G.S. Monument
- 1973 (Land Corner Recordation Certificate) Harold N. Elrich, P.S. 18986 -accessories same as at
- 1974 (Survey -Liber 441, page 291) Bernard Henderson, P.S. 16043 -found ½" iron- accessories same as shown on Elrich's Survey and Land Corner Recordation Certificate.
- 1976 (Land Corner Recordation Certificate) James A. Beck, P.S. 21559 --see over for Continuation


B. Description of corner evidence found and/or method applied in restoring or reestablishing corner:

Found ½" diameter iron rod and remaining accessories.

Accepted found iron rod as marking original corner.

C. Description of monument for corner and accessories established to perpetuate locating the position of the corner:

- Removed iron rod and replaced with Standard Tuscola County Concrete Monument w/2" Brass Cap stamped M5 T11N / R11E
- N45°E 43.64' T.C. Remon. tag in SE face of Telephone pole stub
- S40°W 71.90' T.C. Remon. tag in NW face of power pole
- S60°W 42.21' U.S.G.S. Monument at center of triangle
- N45°W 33.43' set ½" diameter reinforcing rod

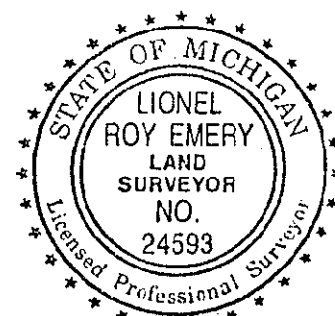

Signed by Lionel Roy Emery Date Aug. 31, 1994
 Surveyor's Michigan License No. 24593

APPROVED
 9-31-94
 [Signatures]

-Found 1/2" Iron Rod- N60°E 51.0' Sign Post; S60°W 42.28' USGS Monument (leaning North);
 S45°W 71.46' RLS 11192 tag in PP
 1977 (Survey -Liber 475, page 399) Kenneth D. Dunton, P.S. 23503 -1/2" Iron - Does not say whether
 found or set- S60°W 42.28' USGS Mon,; S45°W 71.46' RLS 11192 in PP; N45°E 43.51' RLS tag
 11192 in TP

COPY

