

DEC 07 1994

COPY

COMMISSION

1994 REMONUMENTATION PROGRAM
LAND CORNER RECORDATION CERTIFICATE

Filing Requirement of Act 74, Mich. P.A. 1970

For corners in KOYLTON TOWNSHIP

TUSCOLA (County)	Located In:	Corner Code #
1. Public Land Survey	T 11N. R 11E.	M-7
	T _____ R _____	_____
	T _____ R _____	_____
	T _____ R _____	_____
2. Property Controlling in Section	S _____ T _____ R _____	_____
	S _____ T _____ R _____	_____
3. Miscellaneous Property in Sec.	S _____ T _____ R _____	_____
	S _____ T _____ R _____	_____

RECEIVED FOR RECORD
LIBER NO. _____ PAGE NO. _____
FILING NO. H-316
KOYLTON TWP
94 NOV -9 PM 2:20
VIRGINIA M. MCCLAREN
TUSCOLA COUNTY
REGISTER OF DEEDS

Register of Deeds Stamp & File Number

- 4. Lot No. _____, Recorded Plat _____
- 5. Private Claims _____

	A	B	C	D	E	F	G	H	I	J	K	L
2	6		5		4		3		2		1	
3												
4	7		8		9		10		11		12	
5												
6	18		17		16		15		14		13	
7												
8	19		20		21		22		23		24	
9												
10	30		29		28		27		26		25	
11												
12	31		32		33		34		35		36	
13												

I, Lionel Roy Emery, in a field survey on June 22, 1994, do hereby certify that under requirements of P.A. 74, Michigan P.A. of 1970, the corner points mentioned in lines 1 and 2 above were in conformance with regulations and rules therefore as required in the current manual of survey instructions of the United States Department of the Interior, Bureau of Land Management or by a decree of a Court of Law and/or that the corner points mentioned in lines 3, 4 and 5 above were in conformance with the rules of the Michigan Board of Land Surveyors or by a Decree of a Court of Law; established, re-established, monumented, re-monumented, recovered, found as expressed below:

NOTE: Not more than 4 corners, all in the same town and range, may be recorded on this certificate.

A. Description of original monument and accessories and/or subsequent restoration:

- 1834 (Gov't. Land Office Notes) Harvey Parke, D.S. -Set post Cor. Sections 13,24- Hemlock 22 N6W 12; Hemlock 10 S44½W 25
- 1974 (Survey -Liber 438, page 726) Robert G. Kay, P.S. 14096 -shows SE Cor, Sec 13, T11N-R11E- no mention of character of marker found or set, N40°W 80.52' Nail in P.P.; N55°E 48.71' Nail in P.P.; S05°E 27.64' Nail in T.P.
- 1975 (Survey -Liber 448, page 320) Robert G. Kay, P.S. 14096 -Fd ½" Iron- accessories same as above Survey
- 1980 (Survey -Liber 508, page 866) Charles Getz, P.S. 25843 --same marker & accessories as above
- 1986 (Survey -Liber 560, pgs 1038 and 1040) Charles Getz, P.S. 25843 --same marker- N40°W 80.52' Nail in P.P.; S05°E 27.64' Nail in T.P.; N60°E 46.21' Face Road Sign


B. Description of corner evidence found and/or method applied in restoring or reestablishing corner:

Found ½" diameter iron and remaining accessories.

Accepted iron as marking original corner.

C. Description of monument for corner and accessories established to perpetuate locating the position of the corner:

Removed iron and replaced with Standard Tuscola County Concrete Monument w/2" Brass Cap stamped M7 T11N / R11E
N55°E, 46.17' SW face of 2" diameter steel post
S02°E, 27.41' T.C. Remon. tag over found nail and disc in West face of Telephone pole stub
S55°W, 21.22' Set ½" diameter reinforcing rod
N35°W, 80.53' T.C. Remon. tag over found nail and disc in SW face of power pole

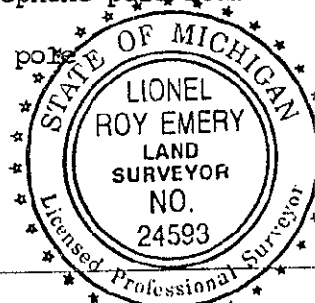

Signed by Lionel Roy Emery Date Aug. 31, 1994

Surveyor's Michigan License No. 24593

APPROVED
8-31-94
[Signature]

COPY

